



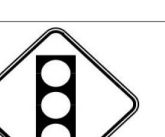

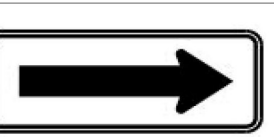


9/29/16
11/3/16

DIR	MILEPOINT	LOCATION CODE	MUTCD CODE	WIDTH	HEIGHT	SHEETING REMARKS	SIGN LEGEND	NEW SIGNS		EXISTING SIGNS				EXIST POST		NUMBER OF NEW POSTS	SQUARE STEEL (in)			TUBULAR STEEL Ø (IN)				SIGN FRAME REQUIRED	REMARKS	SIGN DETAIL		
								"A"	"B"	RETAIN	SALVAGE FROM	SALVAGE TO	REMOVE	RETAIN	REMOVE		1.75	2.00	2.50	3.00	3.50	4.00	5.00			DETAIL IN SHSM	DETAIL ON SHEET NUMBER	DETAIL ON STD SHEET NUMBER
																	(LB / FT)			(LB / FT)								
	LYNDON		US5	SB			FYG-FLUORESCENT YELLOW-GREEN															"SHSM" - STANDARD HIGHWAY SIGNS AND MARKINGS						
		F	VD-018	30	18			3.75							1	11'-3"	X						INSTALL PROPOSED SIGN AT CURRENT LOCATION OF CURVE/SNOWMOBILE ASSEMBLY		6			
SB	4.033	F	W1-2L	30	30			6.25							2	X							INSTALL PROPOSED SIGN ASSEMBLY AT CURRENT LOCATION OF VILLAGE SIGN	X				
		F	W11-6H	30	30			6.25								16'-9"	17'-0"						INSTALL SIGN IN CLOSED POSITION		14			
SB	3.996	F	R2-1	24	30		SPEED LIMIT 35								1	1	14'-0"											
		F	R2-1	30	36			7.50							1	X								X				
SB	3.972	F	W3-3	36	36		SIGNAL AHEAD								1	2	13'-0"											
		F	W3-3	30	30			6.25							1	X								X				
SB	3.956	F	W1-6L	48	24		<--- LEFT								1	2	10'-3"	8'-9"										
		F	W1-6L	48	24			8.00							2	X								X				
SB	3.954	E	W1-6R	48	24		RIGHT --->								1	2	9'-6"	10'-9"										
		E	W1-6R	48	24			8.00							2	X								X				
SB	3.925	F	M2-1	21	15		JCT								1	2												
		F	VM1-5	30	24		VERMONT 122								1													
		F	M2-1	21	15		JCT								1													
		F	VM1-5	30	24		VERMONT 114								1													
SIGN SUMMARY SHEET								SHEET TOTALS		46.00	0.00	0	0	0	8	0	9	9	135	0	0			PROJECT NAME: STATEWIDE- NORTHEAST				
								SF	SF	EA	EA	EA	EA	EA	EA	EA	EA	EA	FT					PROJECT NUMBER: STPG SIGN(56)				
VERMONT AGENCY OF TRANSPORTATION								TOWN TOTALS		236.39	0.0	20.0	0.0	0.0	47.0	17.0	30.0	34	480.0	2	228			FILE NAME: z15T007US5-LYNDON-SB.xls	PLOT DATE: 5/4/2016			
																							PROJECT MANAGER: B. BRESLEND	DRAWN BY: O. DALMER				
																							DESIGNED BY: O. DALMER	CHECKED BY: B. BRESLEND				
																								LYNDON US5 SB 4	SHEET 29	OF 168		