
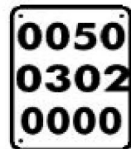
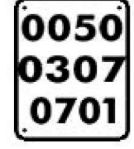




9/30/16

DIR	MILEPOINT	LOCATION CODE	MUTCD CODE	WIDTH	HEIGHT	SHEETING REMARKS	SIGN LEGEND	NEW SIGNS		EXISTING SIGNS				EXIST POST		NUMBER OF NEW POSTS	SQUARE STEEL (in)			TUBULAR STEEL Ø (IN)				SIGN FRAME REQUIRED	REMARKS	SIGN DETAIL		
								"A"	"B"	RETAIN	SALVAGE FROM	SALVAGE TO	REMOVE	RETAIN	REMOVE		1.75	2.00	2.50	3.00	3.50	4.00	5.00			DETAIL IN SHSM	DETAIL ON SHEET NUMBER	DETAIL ON STD SHEET NUMBER
																	(LB / FT)			(LB / FT)								
	BURKE		US5	NB			FYG-FLUORESCENT YELLOW-GREEN															"SHSM" - STANDARD HIGHWAY SIGNS AND MARKINGS						
NB	0.000	C	VD-024	72	10		BURKE / LYNDON					1	X	2														
		C	VD-700	6	8		MM 0050, 0302, 0000																					
		C	VD-700	6	8		MM 0050, 0307, 0701																					
		C	VD-024	72	10			5.00																		T-94		
		C	VD-700	6	10			0.42																			T-44	
		C	VD-700	6	10			0.42																			T-44	
NB	0.255	A	S3-2	36	36		SCHOOL BUS TURN AHEAD			1																		
NB	0.340	C	VR-023b	24	30			5.00																			T-70	
NB	1.182	C	VR-017	24	30			5.00																			T-70	
NB	1.191	A	VD3-1	72	12		BUGBEE CROSSING RD TH-58			1																		
		D	R1-1	30	30		STOP			1																		
NB	1.739	A	VD3-1	72	12		BIG MTN ESTATES PVT			1																		
NB	2.270	A	VD3-1	60	12		PVT COTTAGE LANE			1																		
NB	2.941	A	S3-1	36	36		SCHOOL BUS STOP AHEAD			1																		
NB	3.081	C	VD3-1	24	8		US ROUTE 5																					
SIGN SUMMARY SHEET							SHEET TOTALS	15.84	0.00	6	0	0	4	12	0	2	30							PROJECT NAME: STATEWIDE- NORTHEAST				
								SF	SF	EA	EA	EA	EA	EA	EA	EA	FT						PROJECT NUMBER: STPG SIGN (56)					
VERMONT AGENCY OF TRANSPORTATION							TOWN TOTALS	44.16	0.0	47.0	0.0	0.0	7.0	40.0	2.0	9	135.0							FILE NAME: z15T007US5-BURKE-NB.xls				
																							PLOT DATE: 5/4/2016					
																							PROJECT MANAGER: B. BRESLEND					
																							DESIGNED BY: O. DALMER					
																							CHECKED BY: B. BRESLEND					
																							BURKE US5 NB 1					
																							SHEET 34 OF 168					