



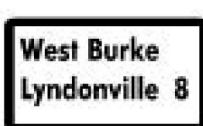



10/5/16

DIR	MILEPOINT	LOCATION CODE	MUTCD CODE	WIDTH	HEIGHT	SHEETING REMARKS	SIGN LEGEND	NEW SIGNS		EXISTING SIGNS				EXIST POST		NUMBER OF NEW POSTS	SQUARE STEEL (in)			TUBULAR STEEL Ø (IN)				SIGN FRAME REQUIRED	REMARKS	SIGN DETAIL		
								"A"	"B"	RETAIN	SALVAGE FROM	SALVAGE TO	REMOVE	RETAIN	REMOVE		1.75	2.00	2.50	3.00	3.50	4.00	5.00			DETAIL IN SHSM	DETAIL ON SHEET NUMBER	DETAIL ON STD SHEET NUMBER
																	(LB / FT)			(LB / FT)								
<b>SUTTON</b>							FYG-FLUORESCENT YELLOW-GREEN															"SHSM" - STANDARD HIGHWAY SIGNS AND MARKINGS						
		H	VD-700	6	10		MM 0050, 0314, 0216 <b>REMOVED; COULD NOT READ M.M.</b>			+	+	1			1		X						SALVAGE SIGN ON NEW POST IN EXISTING LOCATION					
		H	R1-1	30	30			6.25									13'-3"						X					
SB	0.717	F	W1-2L	30	30		CURVE LEFT						1		1													
		F	W13-1P	18	18		40 MPH						1															
SB	0.680	F	W1-2L	30	30			6.25							1		14'-9" X						X		INSTALL SIGN AT BEGINNING OF TANGENT 200 FT SOUTH OF EXISTING SIGN. CLEAR VEGETATION			
SB	0.441	F	W1-2R	30	30			6.25							1		14'-9" X						X		INSTALL SIGN 1262 FEET SOUTH OF LEFT CURVE SIGN			
SB	0.368	F	VD-062C	72	16		C BOARD			1				2														
		F	VD-062AL	72	16		TRAVEL INFO ON LEFT IN VILLAGE			1															REQUIRES VEGETATION CLEARING			
SB	0.212	F	W3-5	36	36		35 MPH AHEAD						1		2													
SB	0.164	F	W3-5	36	36			9.00							2		14'-9" X 14'-9"						X		INSTALL 250 FT SOUTH OF EXISTING SIGN REQUIRES VEGETATION CLEARING			
SB	0.119	F	VD-018	30	18		WEST BURKE / LYNDONVILLE 8						1		1													
		F	VD-018	30	18			3.75							1		12'-3" X							6				
SB	0.076	F	S3-2	36	36		SCHOOL BUS STOP AHEAD			1				1											SYMBOL			
SB	0.037	F	R2-1	24	30		SPEED LIMIT 35						1		1													
		F	R2-1	30	36			7.50							1		X						X					
<b>SIGN SUMMARY SHEET</b>							SHEET TOTALS	39.00	0.00	3	1	1	6	3	5	7	105									PROJECT NAME: STATEWIDE- NORTHEAST PROJECT NUMBER: STPG SIGN(56)		
VERMONT AGENCY OF TRANSPORTATION							TOWN TOTALS	103.83	0.0	6.0	2.0	2.0	20.0	9.0	13.0	18	270.0									FILE NAME: z15T007 US5-SUTTON-SB.xls PLOT DATE: 5/4/2016 PROJECT MANAGER: B. BRESLEND DRAWN BY: O. DALMER DESIGNED BY: O. DALMER CHECKED BY: B. BRESLEND SUTTON US5 SB 3 SHEET 48 OF 168		