


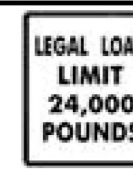


10/20/16

DIR	MILEPOINT	LOCATION CODE	MUTCD CODE	WIDTH	HEIGHT	SHEETING REMARKS	SIGN LEGEND	NEW SIGNS		EXISTING SIGNS				EXIST POST		NUMBER OF NEW POSTS	SQUARE STEEL (in)			TUBULAR STEEL Ø (IN)				SIGN FRAME REQUIRED	REMARKS	SIGN DETAIL		
								"A"	"B"	RETAIN	SALVAGE FROM	SALVAGE TO	REMOVE	RETAIN	REMOVE		1.75	2.00	2.50	3.00	3.50	4.00	5.00			DETAIL IN SHSM	DETAIL ON SHEET NUMBER	DETAIL ON STD SHEET NUMBER
																	(LB / FT)			(LB / FT)								
	DERBY		US5	NB			FYG-FLUORESCENT YELLOW-GREEN															"SHSM" - STANDARD HIGHWAY SIGNS AND MARKINGS						
NB	5.120	A	R2-1	30	36		SPEED LIMIT 30			1																		
		A	VR-040	24	24		STATE HIGHWAY ENDS			1																		
		B	VR-039	24	18		STATE HIGHWAY BEGINS																					
NB	5.216	A	D3-1	42	12		MAIN ST																					
		A	R2-1	24	30		SPEED LIMIT 30																					
		A	W11A-2	30	30		PEDESTRIAN CROSSWALK																					
		A	VD-700	6	10		0050, 1007, 0522																					
		A	W11-2	30	30	FYG		6.25																X				
		A	W7-3aP	24	18	FYG		3.00																X				
NB	5.410	A	R2-1	24	30		SPEED LIMIT 30																					
		A	UNK.	36	36		CAUTION HANDICAP CHILDREN																					
		A	VD-700	6	10		0050, 1007, 0542																					
		A	R2-1	24	30			5.00																X				
NB	5.586	C	VR-017	24	30			5.00																				
NB	5.590	D	VD3-1	42	12		MAIN ST																					
SIGN SUMMARY SHEET							SHEET TOTALS	19.25	0.00	2	2	2	9	1	3	3	45											
								SF	SF	EA	EA	EA	EA	EA	EA	EA	FT											
VERMONT AGENCY OF TRANSPORTATION							TOWN TOTALS	147.58	0.0	10.0	5.0	5.0	34.0	7.0	4.0	16	240.0											
												PROJECT NAME: STATEWIDE- NORTHEAST																
												PROJECT NUMBER: STPG SIGN(56)																
												FILE NAME: z15T007US5-DERBY-NB.xls						PLOT DATE: 5/4/2016										
												PROJECT MANAGER: B. BRESLEND						DRAWN BY: O. DALMER										
												DESIGNED BY: O. DALMER						CHECKED BY: B. BRESLEND										
												DERBY US5 NB 1						SHEET 49 OF 168										