


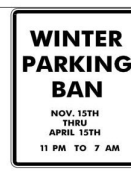




DIR	MILEPOINT	LOCATION CODE	MUTCD CODE	WIDTH	HEIGHT	SHEETING REMARKS	SIGN LEGEND	NEW SIGNS		EXISTING SIGNS				EXIST POST		NUMBER OF NEW POSTS	SQUARE STEEL (in)			TUBULAR STEEL Ø (IN)				SIGN FRAME REQUIRED	REMARKS	SIGN DETAIL		
								"A"	"B"	RETAIN	SALVAGE FROM	SALVAGE TO	REMOVE	RETAIN	REMOVE		1.75	2.00	2.50	3.00	3.50	4.00	5.00			DETAIL IN SHSM	DETAIL ON SHEET NUMBER	DETAIL ON STD SHEET NUMBER
																	(LB / FT)			(LB / FT)								
	<b>DERBY</b>		<b>US5</b>	<b>SB</b>			FYG - FLUORESCENT YELLOW- GREEN															"SHSM" - STANDARD HIGHWAY SIGNS AND MARKINGS						
	SB	5.924	F	VD-018A	30	18	VILLAGE OF DERBY LINE INCORPORATED 1891																					
			F	VD1-421	30	24		5.00																	13			
			F	VD-018	30	18		3.75																	6			
	SB	5.915	F	UNK.	UNK.	UNK.	ENTERING THE UNITED STATES STOP AHEAD FOR INSPECTION			1																		
			F	UNK.	UNK.	UNK.	ATTENTION ALL VEHICLES MUST STOP AND REPORT FOR INSPECTION			1																		
	SB	5.909	F	R3-2	24	24	NO LEFT TURN																					
			F	W11-2	30	30	PEDESTRIAN CROSSWALK																					
			F	R3-2	24	24		4.00																	X			
			F	VD-700	6	10	0050, 1007, 0591				1	1	1													SALVAGE SIGN ON NEW POST IN EXISTING LOCATION		
	SB	5.899	G	R7-3	12	18	WINTER PARKING BAN																					
			G	CUSTOM	24	30		5.00																	15			
			G	CUSTOM	24	30		5.00																	15			
	SB	5.883	G	R7-200	18	24	OVERNIGHT PARKING BY RESIDENT PERMIT ONLY				1	1	1															
			G	R7-3	12	18	WINTER PARKING BAN																					
			G	CUSTOM	24	30		5.00																	15			
<b>SIGN SUMMARY SHEET</b>							<b>SHEET TOTALS</b>	27.75	0.00	2	2	2	7	2	4	4	60											
							SF	SF	EA	EA	EA	EA	EA	EA	EA	EA	FT											
VERMONT AGENCY OF TRANSPORTATION							<b>TOWN TOTALS</b>	104.00	0.0	26.0	3.0	3.0	24.0	16.0	11.0	18	270.0											
												PROJECT NAME:	STATEWIDE- NORTHEAST															
												PROJECT NUMBER:	STPG SIGN(56)															
												FILE NAME:	z15T007US5-DERBY-SB.xls						PLOT DATE:	5/4/2016								
												PROJECT MANAGER:	B. BRESLEND						DRAWN BY:	O. DALMER								
												DESIGNED BY:	O. DALMER						CHECKED BY:	B. BRESLEND								
												DERBY US5 SB 1							SHEET	55		OF	168					

10/20/16

10/20/16  
&  
11/16/16

10/20/16

10/20/16

13'-3"  
X

11'-9"  
X  
INSTALLED  
10/20/16

13'-3"  
X

13'-3"  
X  
INSTALLED  
10/20/16