



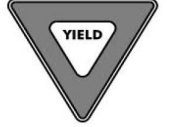


10/20/16
11/10/16

DIR	MILEPOINT	LOCATION CODE	MUTCD CODE	WIDTH	HEIGHT	SHEETING REMARKS	SIGN LEGEND	NEW SIGNS		EXISTING SIGNS				EXIST POST		NUMBER OF NEW POSTS	SQUARE STEEL (in)			TUBULAR STEEL Ø (IN)				SIGN FRAME REQUIRED	REMARKS	SIGN DETAIL					
								"A"	"B"	RETAIN	SALVAGE FROM	SALVAGE TO	REMOVE	RETAIN	REMOVE		1.75	2.00	2.50	3.00	3.50	4.00	5.00			DETAIL IN SHSM	DETAIL ON SHEET NUMBER	DETAIL ON STD SHEET NUMBER			
																	(LB / FT)			(LB / FT)											
	DERBY		US5	SB			FYG - FLUORESCENT YELLOW- GREEN															"SHSM" - STANDARD HIGHWAY SIGNS AND MARKINGS									
		F	UNK.	18	24		DOG WASTE			1	1																				
		F	VD3-1	54	12			4.50																16							
		G	VD3-1	42	12			3.50																	16						
		H	R1-1	30	30			6.25															X								
SB	5.780	F	UNK.	18	24		DOG WASTE				1															SALVAGE SIGN ON NEW POST 30 FEET UP BAXTER AVE. CLOSER TO PARK					
SB	5.767	F	UNK.	UNK.	UNK.		STATE LAW			1																					
		F	UNK.	UNK.	UNK.		DRIVERS HAND HELD ELECTRONIC DEVICES PROHIBITED			1																					
SB	5.737	F	R2-1	18	24		SPEED LIMIT 30					1																			
		F	R2-1	24	30			5.00																X							
SB	5.726	F	UNK.	18	24		DOG WASTE			1																					
SB	5.716	G	VD3-1	42	12		MAIN ST			1																					
		F	VD3-1	36	12		ELM ST			1																					
		H	R1-1	30	30		STOP			1																					
SB	5.716	E	R1-2	36	36		YIELD					1																			
		E	R1-2	36	36			9.00 4.50																X							
SIGN SUMMARY SHEET							SHEET TOTALS				23.75	0.00	6	1	1	3	4	2	6	90	PROJECT NAME: STATEWIDE- NORTHEAST										
											SF	SF	EA	EA	EA	EA	EA	EA	EA	FT	PROJECT NUMBER: STPG SIGN(56)										
VERMONT AGENCY OF TRANSPORTATION							TOWN TOTALS				104.00	0.0	26.0	3.0	3.0	24.0	16.0	11.0	18	270.0	FILE NAME: z15T007US5-DERBY-SB.xls				PLOT DATE: 5/4/2016						
																					PROJECT MANAGER: B. BRESLEND				DRAWN BY: O. DALMER						
																					DESIGNED BY: O. DALMER				CHECKED BY: B. BRESLEND						
																					DERBY US5 SB 3				SHEET 57 OF 168						