
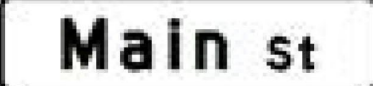




10/20/16

DIR	MILEPOINT	LOCATION CODE	MUTCD CODE	WIDTH	HEIGHT	SHEETING REMARKS	SIGN LEGEND	NEW SIGNS		EXISTING SIGNS				EXIST POST		NUMBER OF NEW POSTS	SQUARE STEEL (in)			TUBULAR STEEL Ø (IN)				SIGN FRAME REQUIRED	REMARKS	SIGN DETAIL		
								"A"	"B"	RETAIN	SALVAGE FROM	SALVAGE TO	REMOVE	RETAIN	REMOVE		1.75	2.00	2.50	3.00	3.50	4.00	5.00			DETAIL IN SHSM	DETAIL ON SHEET NUMBER	DETAIL ON STD SHEET NUMBER
																	(LB / FT)			(LB / FT)								
DERBY			US5	SB	FYG - FLUORESCENT YELLOW- GREEN																	"SHSM" - STANDARD HIGHWAY SIGNS AND MARKINGS						
SB	5.456	F	R2-1	24	30			5.00							1	13'-3" X					INSTALL PROPOSED SIGN BETWEEN SIDEWALK AND ROAD IN GRASS STRIP, 75 FEET NORTH OF DRIVE #502	X						
SB	5.377	G	VD3-1	42	12	MAIN ST																						
		F	VD3-1	48	12	LAYTHE ST																						
		H	R1-1	30	30	STOP																						
		G	VD3-1	42	12								3.50													16		
		F	VD3-1	42	12								3.50														16	
SB	5.347	F	VD3-1	66	12	VALENTINE AVE																						
		H	R1-1	30	30	STOP																						
		G	VD-700	6	10	0050, 1007, 0535																						
SB	5.352	F	VD3-1	66	12								5.50					2	10'-9" X 10'-9"				INSTALL SIGN ON NORTHERN SIDE OF STREET			16		
SB	5.120	F	VR-039	24	18	STATE HIGHWAY BEGINS																						
		F	R2-1	24	30	SPEED LIMIT 40																						
SB	5.120	F	VD3-1	72	12	HAMMERHANDLE RD																						
SIGN SUMMARY SHEET								SHEET TOTALS			17.50	0.00	6	0	0	3	5	0	3	45				PROJECT NAME: STATEWIDE- NORTHEAST				
VERMONT AGENCY OF TRANSPORTATION								SF	SF	EA	EA	EA	EA	EA	EA	EA	EA	EA	EA	FT				PROJECT NUMBER: STPG SIGN(56)				
TOWN TOTALS								104.00	0.0	26.0	3.0	3.0	24.0	16.0	11.0	18	270.0							FILE NAME: z15T007US5-DERBY-SB.xls				
																						PLOT DATE: 5/4/2016						
																						DESIGNED BY: O. DALMER						
																						PROJECT MANAGER: B. BRESLEND						
																						DRAWN BY: O. DALMER						
																						CHECKED BY: B. BRESLEND						
																						DERBY US5 SB 5						
																						SHEET 59 OF 168						