

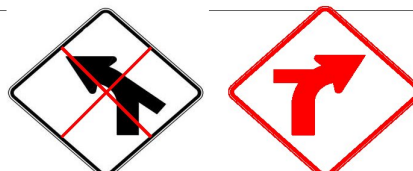




DIR	MILEPOINT	LOCATION CODE	MUTCD CODE	WIDTH	HEIGHT	SHEETING REMARKS	SIGN LEGEND	NEW SIGNS		EXISTING SIGNS				EXIST POST		NUMBER OF NEW POSTS	SQUARE STEEL (in)			TUBULAR STEEL Ø (IN)				SIGN FRAME REQUIRED	REMARKS	SIGN DETAIL		
								"A"	"B"	RETAIN	SALVAGE FROM	SALVAGE TO	REMOVE	RETAIN	REMOVE		(LB / FT)			(LB / FT)						DETAIL IN SHSM	DETAIL ON SHEET NUMBER	DETAIL ON STD SHEET NUMBER
																	1.75	2.00	2.50	3.00	3.50	4.00	5.00					
	SUTTON		VT5A SB				FYG-FLUORESCENT YELLOW-GREEN															"SHSM" - STANDARD HIGHWAY SIGNS AND MARKINGS						
10/18/16 & 11/14/16	SB 2.353	F	W11-14	30	30		HORSE DRAWN VEHICLE TISMO ADDED NEW SIGN & POST IN SAME LOCATION	6.25					1	1	1													
	SB 1.960	F	VD3-1	60	12		SARGENTS RD						2	1									2 REMOVALS @ THIS LOCATION ADDITIONAL WAS A RANDOM POST		17			
		F	VD3-1	60	12		Sargents Rd	5.00							2													
10/18/16	SB 1.960	G	VR-017	24	30		LLL 24,000 LBS						1	1												T-70		
		G	VR-017	24	30			5.00							1													
	SB 1.948	H	R1-1	30	30		STOP						1	1														
		G	VD-700	6	10		MM 0051, 0314, 0194			1	1	1			1								SALVAGE SIGN ON NEW POST IN EXISTING LOCATION					
		H	R1-1	30	30			6.25															X					
11/14/16	SB 0.407	F	W1-2MR	30	30		CURVE RIGHT SIDE RD LEFT						1	1														
		F	W1-10cL	36	36			9.00							2								PLAN DESIGN WAS WRONG ORDERED NEW	X				
	SB 0.357	F	VD-062	74.75	16		FISH HATCHERY <--- 2ND LEFT 6			1				2														
10/17/16	SB 0.242	F	W1-2MR	30	30		CURVE RIGHT SIDE RD LEFT						1	1														
		F	W13-1P	18	18		40 MPH						1															
		F	W1-10R	36	36			9.00							2									X				
		F	W13-1P	18	18			2.25																X				
SIGN SUMMARY SHEET							SHEET TOTALS	36.50	0.00	1	1	1	8	2	6	8	120						PROJECT NAME: STATEWIDE- NORTHEAST					
								SF	SF	EA	EA	EA	EA	EA	EA	EA	FT					PROJECT NUMBER: STPG SIGN(56)						
VERMONT AGENCY OF TRANSPORTATION							TOWN TOTALS	48.75	0.0	1.0	1.0	1.0	10.0	2.0	9.0	11	165.0					FILE NAME: z15T007VT5A-SUTTON-SB.xls	PLOT DATE: 5/4/2016					
																					PROJECT MANAGER: B. BRESLEND	DRAWN BY: O. DALMER						
																					DESIGNED BY: O. DALMER	CHECKED BY: B. BRESLEND						
																					SUTTON VT5A SB 1	SHEET 72 OF 168						