
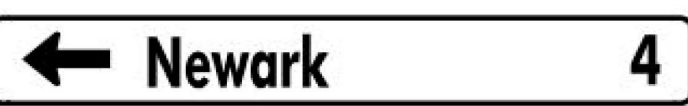


10/17/16

DIR	MILEPOINT	LOCATION CODE	MUTCD CODE	WIDTH	HEIGHT	SHEETING REMARKS	SIGN LEGEND	NEW SIGNS		EXISTING SIGNS			EXIST POST		NUMBER OF NEW POSTS	SQUARE STEEL (in)			TUBULAR STEEL Ø (IN)				SIGN FRAME REQUIRED	REMARKS	SIGN DETAIL			
								"A"	"B"	RETAIN	SALVAGE FROM	SALVAGE TO	REMOVE	RETAIN		REMOVE	1.75	2.00	2.50	3.00	3.50	4.00			5.00	DETAIL IN SHSM	DETAIL ON SHEET NUMBER	DETAIL ON STD SHEET NUMBER
																	(LB / FT)			(LB / FT)								
SUTTON			VT5A	SB			FYG-FLUORESCENT YELLOW-GREEN															"SHSM" - STANDARD HIGHWAY SIGNS AND MARKINGS						
SB	0.206	F	VW-054A	30	30		HIDDEN RDIVE RIGHT																					
		F	VW-054A	30	30			6.25																		T-81		
SB	0.169	F	VD2-1	72	10		<--- NEWARK 4																					
		F	VD1-1A	72	12			6.00																		10		
SB	0.000	G	VD-024	72	10		BURKE / SUTTON																					
								SHEET TOTALS		12.25	0.00	0	0	0	2	0	3	3	45					PROJECT NAME: STATEWIDE- NORTHEAST				
								SF	SF	EA	EA	EA	EA	EA	EA	EA	EA	EA	FT					PROJECT NUMBER: STPG SIGN(56)				
								TOWN TOTALS		48.75	0.0	1.0	1.0	1.0	10.0	2.0	9.0	11	165.0					FILE NAME: z15T007VT5A-SUTTON-SB.xls PLOT DATE: 5/4/2016				
VERMONT AGENCY OF TRANSPORTATION																								DRAWN BY: O. DALMER				
																								DESIGNED BY: O. DALMER CHECKED BY: B. BRESLEND				
																								SUTTON VT5A SB 2 SHEET 73 OF 168				