





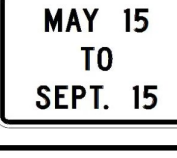


10/19/16

DIR	MILEPOINT	LOCATION CODE	MUTCD CODE	WIDTH	HEIGHT	SHEETING REMARKS	SIGN LEGEND	NEW SIGNS		EXISTING SIGNS				EXIST POST		NUMBER OF NEW POSTS	SQUARE STEEL (in)			TUBULAR STEEL Ø (IN)				SIGN FRAME REQUIRED	REMARKS	SIGN DETAIL		
								"A"	"B"	RETAIN	SALVAGE FROM	SALVAGE TO	REMOVE	RETAIN	REMOVE		(LB / FT)			(LB / FT)						DETAIL IN SHSM	DETAIL ON SHEET NUMBER	DETAIL ON STD SHEET NUMBER
																	1.75	2.00	2.50	3.00	3.50	4.00	5.00					
WESTMORE VT5A NB							FYG-FLUORESCENT YELLOW-GREEN															"SHSM" - STANDARD HIGHWAY SIGNS AND MARKINGS						
NB	1.245	A	W7-1a	30	30		HILL 9% GRADE																					
		A	W7-1a	30	30			6.25																X				
NB	1.286	A	W3-5	36	36		SPEED LIMIT 35 AHEAD																					
		A	UNK.	30	24		MAY 15 TO SEPT 15																					
		A	W3-5	36	36			9.00																X				
		A	VR-147	30	24			5.00																	15			
NB	1.324	A	VW-219	30	30		SUMMER CAMP AREA																					
		A	VW-219	30	30			6.25																	15			
NB	1.371	A	W11-2	30	30		PEDESTRIAN																					
		A	W11-2	30	30	FYG		6.25																X				
NB	1.414	A	R2-1	30	36		SPEED LIMIT 35																					
		A	UNK.	30	24		MAY 15 TO SEPT 15																					
		A	R2-1	30	36			7.50																X				
		A	VR-147	30	24			5.00																	15			
NB	1.445	A	W1-4R	30	30		RIGHT REVERSE CURVE																					
SIGN SUMMARY SHEET							SHEET TOTALS	45.25	0.00	0	0	0	8	1	7	5	75							PROJECT NAME: STATEWIDE- NORTHEAST				
							SF	SF	EA	EA	EA	EA	EA	EA	EA	EA	FT							PROJECT NUMBER: STPG SIGN(56)				
VERMONT AGENCY OF TRANSPORTATION							TOWN TOTALS	310.66	0.0	24.0	1.0	1.0	61.0	32.0	39.0	39	585.0							FILE NAME: z15T007VT5A-WESTMORE-NB PLOT DATE: 5/4/2016				
																								PROJECT MANAGER: B. BRESLEND DRAWN BY: O. DALMER				
																								DESIGNED BY: O. DALMER CHECKED BY: B. BRESLEND				
																								WESTMORE VT5A NB 2 SHEET 77 OF 168				