


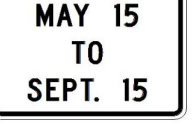





10/19/16
10/20/16

DIR	MILEPOINT	LOCATION CODE	MUTCD CODE	WIDTH	HEIGHT	SHEETING REMARKS	SIGN LEGEND	NEW SIGNS		EXISTING SIGNS				EXIST POST		NUMBER OF NEW POSTS	SQUARE STEEL (in)			TUBULAR STEEL Ø (IN)				SIGN FRAME REQUIRED	REMARKS	SIGN DETAIL		
								"A"	"B"	RETAIN	SALVAGE FROM	SALVAGE TO	REMOVE	RETAIN	REMOVE		1.75	2.00	2.50	3.00	3.50	4.00	5.00			DETAIL IN SHSM	DETAIL ON SHEET NUMBER	DETAIL ON STD SHEET NUMBER
																	(LB / FT)			(LB / FT)								
	WESTMORE		VT5A	NB			FYG-FLUORESCENT YELLOW-GREEN															"SHSM" - STANDARD HIGHWAY SIGNS AND MARKINGS						
		A	W1-4R	30	30			6.25							1	14'-3" X							X					
NB	1.482	A	VW-054R	30	30		HIDDEN DRIVE RIGHT																					
		A	VW-054R	30	30			6.25							1	13'-3" X									T-81			
NB	1.556	A	R2-1	24	30		SPEED LIMIT 35																					
		A	UNK.	24	18		MAY 15 TO SEPT 15																					
		A	R2-1	24	30			5.00							1	15'-3" X							X		REQUIRES VEGETATION CLEARING			
		A	VR-147	24	18			3.00																15				
NB	1.828	A	VW-444	36	36		WATCH FOR FALLEN ROCK																					
		A	W7-3aP	24	18		NEXT 2 MILES																					
		A	VW-285	30	30			6.25																	15			
		A	W7-3aP	24	18			3.00															X					
NB	1.920	A	R2-1	24	30		SPEED LIMIT 50																					
		A	R2-1	24	30			5.00							1	14'-9" X							X					
NB	1.961	A	W1-5R	30	30		RIGHT WINDING CURVES																					
		A	W13-1P	18	18		40 M PH																					
SIGN SUMMARY SHEET								SHEET TOTALS		34.75	0.00	0	0	0	8	2	4	4	60					PROJECT NAME: STATEWIDE- NORTHEAST				
								SF	SF	EA	EA	EA	EA	EA	EA	EA	EA	EA	FT					PROJECT NUMBER: STPG SIGN(56)				
VERMONT AGENCY OF TRANSPORTATION								TOWN TOTALS		310.66	0.0	24.0	1.0	1.0	61.0	32.0	39.0	39	585.0					FILE NAME: z15T007VT5A-WESTMORE-NB PLOT DATE: 5/4/2016				
																							PROJECT MANAGER: B. BRESLEND DRAWN BY: O. DALMER					
																							DESIGNED BY: O. DALMER CHECKED BY: B. BRESLEND					
																							WESTMORE VT5A NB 3 SHEET 78 OF 168					