




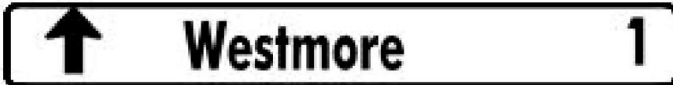


10/26/16

DIR	MILEPOINT	LOCATION CODE	MUTCD CODE	WIDTH	HEIGHT	SHEETING REMARKS	SIGN LEGEND	NEW SIGNS		EXISTING SIGNS			EXIST POST		NUMBER OF NEW POSTS	SQUARE STEEL (in)			TUBULAR STEEL Ø (IN)				SIGN FRAME REQUIRED	REMARKS	SIGN DETAIL			
								"A"	"B"	RETAIN	SALVAGE FROM	SALVAGE TO	REMOVE	RETAIN		REMOVE	1.75	2.00	2.50	3.00	3.50	4.00			5.00	DETAIL IN SHSM	DETAIL ON SHEET NUMBER	DETAIL ON STD SHEET NUMBER
																	(LB / FT)			(LB / FT)								
WESTMORE							FYG-FLUORESCENT YELLOW-GREEN															"SHSM" - STANDARD HIGHWAY SIGNS AND MARKINGS						
SB	6.718	F	VD1-1A	72	12			6.00																10				
		F	VD1-1A	72	12			6.00																10				
		F	VD1-1A	72	12			6.00																10				
SB	6.747	F	M3-3	24	12		SOUTH																					
		F	VM1-5	24	24		VT 5A																					
		F	M6-3	21	15		UP ARROW																					
		F	M3-3	24	12		SOUTH																					
		F	VM1-5A	24	24		RT 16																					
		F	M6-1R	21	15		RIGHT ---->																					
SB	6.681	F	M3-3	24	12			2.00														2A	GREEN ON WHITE	X				
		F	VM1-5	24	24			4.00															INSTALL PRPOSED SIGN ASSEMBLY 350 FEET SOUTH OF EXISTING		E-136B			
		F	M6-3	21	15			2.19															GREEN ON WHITE	X				
		F	M3-3	24	12			2.00															BLACK ON WHITE	X				
		F	VM1-5A	24	24			4.00																	E-136C			
		F	M6-1R	21	15			2.19															BLACK ON WHITE	X				
SIGN SUMMARY SHEET							SHEET TOTALS	34.38	0.00	0	0	0	6	0	2	2	30					PROJECT NAME: STATEWIDE- NORTHEAST						
								SF	SF	EA	EA	EA	EA	EA	EA	EA	FT					PROJECT NUMBER: STPG SIGN(56)						
VERMONT AGENCY OF TRANSPORTATION							TOWN TOTALS	293.07	0.0	18.0	2.0	3.0	59.0	33.0	29.0	30	450.0					FILE NAME: z15T007VT5A-WESTMORE-SB	PLOT DATE: 5/4/2016					
																						PROJECT MANAGER: B. BRESLEND	DRAWN BY: O. DALMER					
																						DESIGNED BY: O. DALMER	CHECKED BY: B. BRESLEND					
																						WESTMORE VT5A SB 2	SHEET 87	OF 168				