



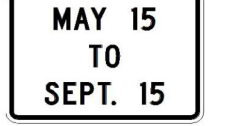





DIR	MILEPOINT	LOCATION CODE	MUTCD CODE	WIDTH	HEIGHT	SHEETING REMARKS	SIGN LEGEND	NEW SIGNS		EXISTING SIGNS				EXIST POST		NUMBER OF NEW POSTS	SQUARE STEEL (in)			TUBULAR STEEL Ø (IN)				SIGN FRAME REQUIRED	REMARKS	SIGN DETAIL		
								"A"	"B"	RETAIN	SALVAGE FROM	SALVAGE TO	REMOVE	RETAIN	REMOVE		1.75	2.00	2.50	3.00	3.50	4.00	5.00			DETAIL IN SHSM	DETAIL ON SHEET NUMBER	DETAIL ON STD SHEET NUMBER
																	(LB / FT)			(LB / FT)								
	WESTMORE		VT5A SB				FYG-FLUORESCENT YELLOW-GREEN															"SHSM" - STANDARD HIGHWAY SIGNS AND MARKINGS						
		F	UNK.	30	24		MAY 15 TO SEPT 15																					
		F	W3-5	36	36			9.00															X					
		F	VR-147	30	24			5.00																	15			
	SB 1.960	F	VW-219	30	30		SUMMER CAMP AREA																					
		F	VW-219	30	30			6.25																		15		
	SB 1.920	F	R2-1	30	36		SPEED LIMIT 35																					
		F	UNK.	30	24		MAY 15 TO SEPT 15																					
		F	R2-1	30	36			7.50															X					
		F	VR-147	30	24			5.00																	15			
	SB 1.891	F	W11-2	30	30		PEDESTRIAN																					
		F	W11-2	30	30	FYG		6.25															X					
	SB 1.838	F	W1-5R	30	30		RIGHT WINDING CURVE																					
		F	W13-1P	18	18		35 MPH																					
	SB 1.780	F	W1-5R	30	30			6.25															X					
		F	W13-1P	18	18			2.25															X					
SIGN SUMMARY SHEET							SHEET TOTALS	47.50	0.00	0	0	0	7	0	4	6	90						PROJECT NAME: STATEWIDE- NORTHEAST					
								SF	SF	EA	EA	EA	EA	EA	EA	EA	FT					PROJECT NUMBER: STPG SIGN(56)						
VERMONT AGENCY OF TRANSPORTATION							TOWN TOTALS	293.07	0.0	18.0	2.0	3.0	59.0	33.0	29.0	30	450.0						FILE NAME: z15T007VT5A-WESTMORE-SB	PLOT DATE: 5/4/2016				
																						PROJECT MANAGER: B. BRESLEND	DRAWN BY: O. DALMER					
																						DESIGNED BY: O. DALMER	CHECKED BY: B. BRESLEND					
																						WESTMORE VT5A SB 8	SHEET 93	OF 168				

10/26/16
10/20/16
10/26/16
10/19/16