
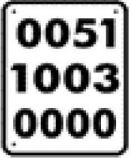






DIR	MILEPOINT	LOCATION CODE	MUTCD CODE	WIDTH	HEIGHT	SHEETING REMARKS	SIGN LEGEND	NEW SIGNS		EXISTING SIGNS			EXIST POST		NUMBER OF NEW POSTS	SQUARE STEEL (in)			TUBULAR STEEL Ø (IN)				SIGN FRAME REQUIRED	REMARKS	SIGN DETAIL			
								"A"	"B"	RETAIN	SALVAGE FROM	SALVAGE TO	REMOVE	RETAIN		REMOVE	1.75	2.00	2.50	3.00	3.50	4.00			5.00	DETAIL IN SHSM	DETAIL ON SHEET NUMBER	DETAIL ON STD SHEET NUMBER
																	(LB / FT)			(LB / FT)								
BROWNINGTON			VT5A	NB	FYG-FLUORESCENT YELLOW-GREEN																	"SHSM" - STANDARD HIGHWAY SIGNS AND MARKINGS						
NB	0.000	C	VD-024	72	10		BROWNINGTON / WESTMORE					1	1															
		C	VD-700	6	8		MM 0051, 1003, 0000					1																
		C	VD-700	6	8		MM 0051, 1019, 0722					1																
		C	VD-024	72	10			5.00						2												T-94		
		C	VD-700	6	10			0.42																		T-44		
		C	VD-700	6	10			0.42																		T-44		
NB	0.352	A	W1-2L	30	30		LEFT CURVE					1	1															
		A	W13-1P	18	18		40 MPH					1																
		A	W1-2L	30	30			6.25						1										X				
NB	0.529	A	VD-062AS	72	16		<--- EVANSVILLE TRADING POST			1			2													TRADING POST		
NB	0.566	A	M2-1	21	15		JCT					1	1															
		A	VM1-5	24	24		ROUTE 58					1																
		A	M2-1	21	15			2.19						1										X				
		A	VM1-5	24	24			4.00																		E-136B		
NB	0.606	A	VD1-1A	72	12		<--- (45 DEG) EVANSVILLE 3					1	2															
SIGN SUMMARY SHEET							SHEET TOTALS		18.28	0.00	1	0	0	8	2	5	4	60					PROJECT NAME: STATEWIDE- NORTHEAST					
							SF	SF	EA	EA	EA	EA	EA	EA	EA	EA	EA	FT					PROJECT NUMBER: STPG SIGN(56)					
VERMONT AGENCY OF TRANSPORTATION							TOWN TOTALS		127.41	0.0	6.0	1.0	1.0	28.0	12.0	11.0	14	210.0					FILE NAME: z15T007VT5A-BROWNINGTON	PLOT DATE: 5/4/2016				
																						PROJECT MANAGER: B. BRESLEND	DRAWN BY: O. DALMER					
																						DESIGNED BY: O. DALMER	CHECKED BY: B. BRESLEND					
																						BROWNINGTON VT5A NB 1	SHEET 95	OF 168				

10/24/16

10/25/16