




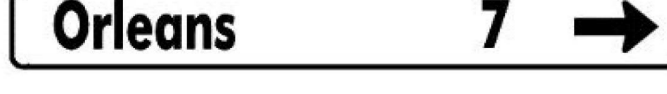


10/27/16

DIR	MILEPOINT	LOCATION CODE	MUTCD CODE	WIDTH	HEIGHT	SHEETING REMARKS	SIGN LEGEND	NEW SIGNS		EXISTING SIGNS				EXIST POST		NUMBER OF NEW POSTS	SQUARE STEEL (in)			TUBULAR STEEL Ø (IN)				SIGN FRAME REQUIRED	REMARKS	SIGN DETAIL		
								"A"	"B"	RETAIN	SALVAGE FROM	SALVAGE TO	REMOVE	RETAIN	REMOVE		1.75	2.00	2.50	3.00	3.50	4.00	5.00			DETAIL IN SHSM	DETAIL ON SHEET NUMBER	DETAIL ON STD SHEET NUMBER
																	(LB / FT)			(LB / FT)								
BROWNINGTON			VT5A	SB	FYG-FLUORESCENT YELLOW-GREEN																		"SHSM" - STANDARD HIGHWAY SIGNS AND MARKINGS					
SB	0.788	F	M2-1	21	15		JCT																					
		F	VM1-5	24	24		ROUTE 58																					
		F	VD-700	6	10		MM 0051, 1003, 0079																					
		F	M2-1	21	15			2.19																				
		F	VM1-5	24	24			4.00																		E-136B		
SB	0.750	F	VD1-1A	72	10		<--- (45 DEG) LAKE WILLOUGHBY 2																					
		F	VD1-1A	72	10		<--- (45 DEG) WEST BURKE 13																					
		F	VD1-1A	72	10		ORLEANS 7--->																					
		F	VD1-1A	72	10		EVAVNSVILLE 3--->																					
		F	VD1-1A	72	12			6.00																		9		
		F	VD1-1A	72	12			6.00																		9		
		F	VD1-1A	72	12			6.00																		9		
		F	VD1-1A	72	12			6.00																		9		
SB	0.710	F	M3-3	24	12		SOUTH																					
		F	VM1-5	24	24		ROUTE 58																					
SIGN SUMMARY SHEET							SHEET TOTALS		30.19	0.00	0	1	1	9	4	1	1	15						PROJECT NAME: STATEWIDE- NORTHEAST				
							SF	SF	EA	EA	EA	EA	EA	EA	EA	EA	EA	FT						PROJECT NUMBER: STPG SIGN(56)				
VERMONT AGENCY OF TRANSPORTATION							TOWN TOTALS		161.57	0.0	9.0	3.0	3.0	35.0	19.0	10.0	17	255.0						FILE NAME: z15T007VT5A-BROWNINGTON	PLOT DATE: 5/4/2016			
																							DESIGNED BY: O. DALMER	DRAWN BY: O. DALMER				
																							CHECKED BY: B. BRESLEND	SHEET 102 OF 168				