

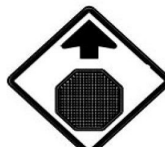




DIR	MILEPOINT	LOCATION CODE	MUTCD CODE	WIDTH	HEIGHT	SHEETING REMARKS	SIGN LEGEND	NEW SIGNS		EXISTING SIGNS				EXIST POST		NUMBER OF NEW POSTS	SQUARE STEEL (in)			TUBULAR STEEL Ø (IN)				SIGN FRAME REQUIRED	REMARKS	SIGN DETAIL		
								"A"	"B"	RETAIN	SALVAGE FROM	SALVAGE TO	REMOVE	RETAIN	REMOVE		1.75	2.00	2.50	3.00	3.50	4.00	5.00			DETAIL IN SHSM	DETAIL ON SHEET NUMBER	DETAIL ON STD SHEET NUMBER
																	(LB / FT)			(LB / FT)								
CHARLESTON			VT5A	NB	FYG-FLUORESCENT YELLOW-GREEN																	"SHSM" - STANDARD HIGHWAY SIGNS AND MARKINGS						
NB	3.269	A	VD3-1	18	6	ASPEN DR PVT																						
		A	VD3-1	60	12		5.00																	17				
NB	3.436	A	VD3-1	18	6	ISLAND RD PVT																						
		A	VD3-1	60	12		5.00																		17			
NB	3.678	A	W3-1	36	36	STOP AHEAD																						
		A	W3-1	30	30		6.25																	X				
NB	3.752	A	M2-1	21	15	JCT																						
		A	VM1-5	30	24	VT 105																						
		A	M4-6	24	12	END																						
		A	VM1-5	24	24	VT 5A																						
		A	M2-1	21	15		2.19																	X				
		A	VM1-5	30	24		5.00																			E-136B		
		A	M4-6	24	12		2.00																	X				
		A	VM1-5	24	24		4.00																			E-136B		
NB	3.792	A	VD1-1A	72	10	<--- WEST CHARLESTON																						
SIGN SUMMARY SHEET							SHEET TOTALS			29.44	0.00	0	0	0	8	0	8	7	105					PROJECT NAME: STATEWIDE- NORTHEAST PROJECT NUMBER: STPG SIGN(56)				
VERMONT AGENCY OF TRANSPORTATION							SF	SF	EA	EA	EA	EA	EA	EA	EA	EA	EA	EA	EA	FT					FILE NAME: z15T007VT5A-CHARLESTON-1 PROJECT MANAGER: B. BRESLEND DESIGNED BY: O. DALMER CHARLESTON VT5A NB 3	PLOT DATE: 5/4/2016 DRAWN BY: O. DALMER CHECKED BY: B. BRESLEND SHEET 108 OF 168		
							TOWN TOTALS			143.91	0.0	4.0	1.0	1.0	31.0	7.0	18.0	26	390.0									

11/4/16

11/7/16