






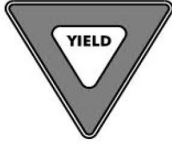


DIR	MILEPOINT	LOCATION CODE	MUTCD CODE	WIDTH	HEIGHT	SHEETING REMARKS	SIGN LEGEND	NEW SIGNS		EXISTING SIGNS				EXIST POST		NUMBER OF NEW POSTS	SQUARE STEEL (in)			TUBULAR STEEL Ø (IN)				SIGN FRAME REQUIRED	REMARKS	SIGN DETAIL		
								"A"	"B"	RETAIN	SALVAGE FROM	SALVAGE TO	REMOVE	RETAIN	REMOVE		1.75	2.00	2.50	3.00	3.50	4.00	5.00			DETAIL IN SHSM	DETAIL ON SHEET NUMBER	DETAIL ON STD SHEET NUMBER
																	(LB / FT)			(LB / FT)								
	LYNDON	VT114	NB				FYG-FLUORESCENT YELLOW-GREEN															"SHSM" - STANDARD HIGHWAY SIGNS AND MARKINGS						
		A	R1-2	30	30		YIELD															SLIP LANE BACK TO BACK						
11/4/16		A	R1-2	36	36			4.50						1	2		13'-3" X	ONE POST				PLACE SIGN MIN. 6 FEET FROM "DO NOT ENTER" SIGN	X					
	NB	0.064	B	R5-1	30			6.25						1			13'-3" X					PLACE SIGN MIN. 6 FEET FROM "YIELD" SIGN	X					
11/9/16	NB	0.065	K	OM1-1	18									1									X					
		K	OM1-1	18	18			2.25						1			9'-6" X						X					
	NB	0.086	A	VD3-1	54		PVT SLATE LN		1					1														
	NB	0.114	A	M3-1	24		NORTH																					
		A	M1-5	30	24		VT 114																					
		A	UNK.	12	24		NEK															SALVAGE SIGN ON NEW POST BELOW ROUTE ASSEMBLY						
10/21/16		A	M3-1	24	12			2.00						1			15'-0" X					GREEN ON WHITE	X					
		A	M1-5	30	24			5.00																	E-136B			
	NB	0.141	A	VD2-1	72			6.00						2			14'-0" X 14'-6"					INSTALL PROPOSED ASSEMBLY 10 FEET SOUTH OF POLE #176/445/37/4		11				
		A	VD2-1	72	12			6.00																11				
10/27/16	NB	0.171	B	W3-3	36		SIGNAL AHEAD															SYMBOL						
10/21/16		B	W3-3	30	30			6.25						1			14'-0" X						X					
SIGN SUMMARY SHEET							SHEET TOTALS		38.25	0.00	1	1	1	6	1	4	8	120	PROJECT NAME: STATEWIDE- NORTHEAST									
VERMONT AGENCY OF TRANSPORTATION							SF	SF	EA	EA	EA	EA	EA	EA	EA	EA	EA	EA	FT	PROJECT NUMBER: STPG SIGN(56)								
							TOWN TOTALS		249.32	0.0	22.0	6.0	6.0	52.0	33.0	31.0	41	615.0	FILE NAME: z15t007vT114-LYNDON-NB.xls				PLOT DATE: 5/4/2016					
																			PROJECT MANAGER: B. BRESLEND				DRAWN BY: O. DALMER					
																			DESIGNED BY: O. DALMER				CHECKED BY: B. BRESLEND					
																			LYNDON VT114 NB 2				SHEET 115 OF 168					