




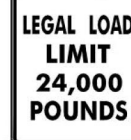


DIR	MILEPOINT	LOCATION CODE	MUTCD CODE	WIDTH	HEIGHT	SHEETING REMARKS	SIGN LEGEND	NEW SIGNS		EXISTING SIGNS				EXIST POST		NUMBER OF NEW POSTS	SQUARE STEEL (in)			TUBULAR STEEL Ø (IN)				SIGN FRAME REQUIRED	REMARKS	SIGN DETAIL		
								"A"	"B"	RETAIN	SALVAGE FROM	SALVAGE TO	REMOVE	RETAIN	REMOVE		1.75	2.00	2.50	3.00	3.50	4.00	5.00			DETAIL IN SHSM	DETAIL ON SHEET NUMBER	DETAIL ON STD SHEET NUMBER
																	(LB / FT)			(LB / FT)								
	LYNDON		VT114 SB				FYG-FLUORESCENT YELLOW-GREEN															"SHSM" - STANDARD HIGHWAY SIGNS AND MARKINGS						
		F	VD-062BC	74.75	16		TRAVEL INFORMATION ^UP US 5 SOUTH TO PARK 2			1																		
	SB	0.644	F	S3-1	30		SCHOOL BUS STOP AHEAD					1	1															
	SB	0.644	G	VR-017	24		LLL 24,000 LBS					1	1															
			G	VR-017	24			5.00																	T-70			
	SB	0.640	F	VD3-1	42		COZY BEND LN TH 118					1	1															
			F	VD3-1	72			6.00						2											19			
	SB	0.633	H	R1-1	30		STOP					1	1															
			G	VD-700	6		MM 1140, 0307, 0640			1																		
			H	R1-1	30			6.25															X					
	SB	0.595	G	VD3-1	42		DARLING HILL RD TH5					1	1															
			F	VD3-1	42		EAST BURKE RD ST114					1																
			F	VD3-1	66			6.00						3											18			
			G	VD3-1	72			5.50																	19			
	SB	0.593	G	VR-017	24		LLL 24,000 LBS					1	1															
			G	VR-017	24			5.00						1											T-70			
SIGN SUMMARY SHEET							SHEET TOTALS	33.75	0.00	2	0	0	7	2	4	6	90	0	0					PROJECT NAME: STATEWIDE- NORTHEAST				
								SF	SF	EA	EA	EA	EA	EA	EA	EA	FT						PROJECT NUMBER: STPG SIGN(56)					
VERMONT AGENCY OF TRANSPORTATION							TOWN TOTALS	203.71	0.0	11.0	0.0	0.0	41.0	24.0	18.0	22	300.0	2	228					FILE NAME: z15T007Vt114-LYNDON-SB.xls	PLOT DATE: 5/4/2016			
																							PROJECT MANAGER: B. BRESLEND	DRAWN BY: O. DALMER				
																							DESIGNED BY: O. DALMER	CHECKED BY: B. BRESLEND				
																							LYNDON VT114 SB 3	SHEET 125 OF 168				

10/27/16
10/28/16
10/27/16
11/4/16
10/27/16