


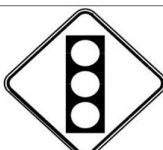


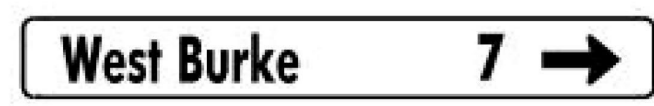


DIR	MILEPOINT	LOCATION CODE	MUTCD CODE	WIDTH	HEIGHT	SHEETING REMARKS	SIGN LEGEND	NEW SIGNS		EXISTING SIGNS			EXIST POST		NUMBER OF NEW POSTS	SQUARE STEEL (in)			TUBULAR STEEL Ø (IN)				SIGN FRAME REQUIRED	REMARKS	SIGN DETAIL				
								"A"	"B"	RETAIN	SALVAGE FROM	SALVAGE TO	REMOVE	RETAIN		REMOVE	1.75	2.00	2.50	3.00	3.50	4.00			5.00	DETAIL IN SHSM	DETAIL ON SHEET NUMBER	DETAIL ON STD SHEET NUMBER	
																	(LB / FT)			(LB / FT)									
	LYNDON	VT114	SB				FYG-FLUORESCENT YELLOW-GREEN															"SHSM" - STANDARD HIGHWAY SIGNS AND MARKINGS							
		F	VM1-5	30	24			5.00																	136B				
		F	M2-1	21	15		  	2.19															10'-6" X 9'-6"		BLACK ON WHITE	X			
		F	M1-4	24	24			4.00																	X				
		F	M4-6	24	12			2.00																	X	GREEN ON WHITE			
		F	VM1-5	30	24			5.00																		INSTALL PROPOSED ASSEMBLY 200 FEET NORTH OF SIGNAL AHEAD ADVANCE WARNING SIGNS	136B		
SB	0.171	F	W3-3	36	36		SIGNAL AHEAD																				SYMBOL		
		F	W3-3	30	30			6.25																		X			
SB	0.115	F	VD1-1A	72	12		WHEELOCK 6																						
		F	VD1-1A	72	12		LYNDONVILLE 1																						
		F	VD1-1A	72	12		WEST BURKE 7																						
		F	VD1-1A	72	12			6.00																					12
		F	VD1-1A	72	12			6.00																					12
		F	VD1-1A	72	12			6.00																					12
		F	M3-3	24	12		SOUTH																						
		F	M1-4	24	24		US 5																						
SIGN SUMMARY SHEET							SHEET TOTALS	42.44	0.00	0	0	0	6	0	6	3	45	0	0					PROJECT NAME: STATEWIDE- NORTHEAST					
								SF	SF	EA	EA	EA	EA	EA	EA	EA	FT						PROJECT NUMBER: STPG SIGN(56)						
VERMONT AGENCY OF TRANSPORTATION							TOWN TOTALS	203.71	0.0	11.0	0.0	0.0	41.0	24.0	18.0	22	300.0	2	228					FILE NAME: z15T007Vt114-LYNDON-SB.xls	PLOT DATE: 5/4/2016				
																							PROJECT MANAGER: B. BRESLEND	DRAWN BY: O. DALMER					
																							DESIGNED BY: O. DALMER	CHECKED BY: B. BRESLEND					
																							LYNDON VT114 SB 5	SHEET 127	OF 168				

11/16/16
 10/27/16
 11/11/16