


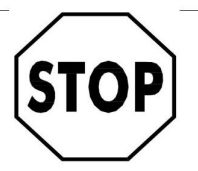





11/2/16

DIR	MILEPOINT	LOCATION CODE	MUTCD CODE	WIDTH	HEIGHT	SHEETING REMARKS	SIGN LEGEND	NEW SIGNS		EXISTING SIGNS				EXIST POST		NUMBER OF NEW POSTS	SQUARE STEEL (in)			TUBULAR STEEL Ø (IN)				SIGN FRAME REQUIRED	REMARKS	SIGN DETAIL		
								"A"	"B"	RETAIN	SALVAGE FROM	SALVAGE TO	REMOVE	RETAIN	REMOVE		1.75	2.00	2.50	3.00	3.50	4.00	5.00			DETAIL IN SHSM	DETAIL ON SHEET NUMBER	DETAIL ON STD SHEET NUMBER
																	(LB / FT)			(LB / FT)								
<b>BURKE VT114 NB</b>							FYG-FLUORESCENT YELLOW-GREEN															"SHSM" - STANDARD HIGHWAY SIGNS AND MARKINGS						
NB	1.326	A	VD3-1	24	6		CARR DR																					
		A	VD3-1	36	12			3.00																	18			
NB	2.353	A	VD3-1	72	12		PINKHAM RD																					
		C	VR-017	24	30		LLL 24,000 LBS																					
		A	VD3-1	72	12			6.00																	18			
NB	2.354	C	VR-017	24	30			5.00															PLACE SIGN MINIMUM 20 FEET FROM INTERSECTION ON SOUTH SIDE OF ROAD			T-70		
NB	2.362	D	R1-1	30	30		STOP																					
		D	R1-1	30	30			6.25																X				
NB	2.576	A	VD3-1	30	8		SMITH'S HILL RD																					
		A	VD3-1	72	12			6.00																	18			
NB	2.578	C	VR-017	24	30		LLL 24,000 LBS																					
		C	VR-017	24	30			5.00																	T-70			
NB	2.585	D	R1-1	30	30		STOP																					
		C	VD-700	6	10		MM 1140, 0302, 0258																					
		D	R1-1	30	30			6.25																X				
<b>SIGN SUMMARY SHEET</b>							SHEET TOTALS	37.50	0.00	0	1	1	8	1	5	8	120					PROJECT NAME: STATEWIDE- NORTHEAST						
VERMONT AGENCY OF TRANSPORTATION							TOWN TOTALS	264.34	0.0	12.0	2.0	2.0	47.0	17.0	34.0	47	705.0					PROJECT NUMBER: STPG SIGN(56)						
								SF	SF	EA	EA	EA	EA	EA	EA	EA	FT					FILE NAME: z15T007VT114-BURKE-NB.xls	PLOT DATE: 5/4/2016					
																						PROJECT MANAGER: B. BRESLEND	DRAWN BY: O. DALMER					
																						DESIGNED BY: O. DALMER	CHECKED BY: B. BRESLEND					
																						BURKE VT114 NB 5	SHEET 134 OF 168					