
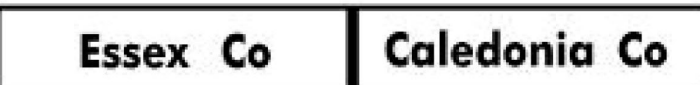
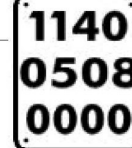
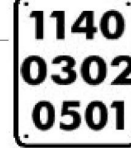




DIR	MILEPOINT	LOCATION CODE	MUTCD CODE	WIDTH	HEIGHT	SHEETING REMARKS	SIGN LEGEND	NEW SIGNS		EXISTING SIGNS				EXIST POST		NUMBER OF NEW POSTS	SQUARE STEEL (in)			TUBULAR STEEL Ø (IN)				SIGN FRAME REQUIRED	REMARKS	SIGN DETAIL		
								"A"	"B"	RETAIN	SALVAGE FROM	SALVAGE TO	REMOVE	RETAIN	REMOVE		1.75	2.00	2.50	3.00	3.50	4.00	5.00			DETAIL IN SHSM	DETAIL ON SHEET NUMBER	DETAIL ON STD SHEET NUMBER
																	(LB / FT)			(LB / FT)								
EAST HAVEN			VT114	NB	FYG-FLUORESCENT YELLOW-GREEN																	"SHSM" - STANDARD HIGHWAY SIGNS AND MARKINGS						
NB	0.000	C	VD-024	72	10	EAST HAVEN / BURKE																						
		C	VD-025	72	10	ESSEX CO / CALEDONIA CO																						
		C	VD-700	6	8	MM 1140, 0302, 0501																						
		C	VD-025	72	10		5.00																		T-94			
		C	VD-024	72	10		5.00																			T-94		
		C	VD-700	6	10		0.42																			T-44		
		C	VD-700	6	10		0.42																			T-44		
NB	0.138	A	VD1-1A	72	12	EAST HAVEN --->			1																			
NB	0.168	C	VR-017	24	30	LLL 24,000 LBS																						
		C	VR-017	24	30		5.00																			T-70		
NB	0.168	C	R2-1	24	30	SPEED LIMIT 25				1	1	1	1													MOVE SIGN ON TOP OF EXISTING POST		
NB	0.178	D	R1-1	30	3	STOP																						
		C	VD-700	6	10	MM 1140, 0508, 0018																						
		D	R1-1	30	30		6.25																			X		
NB	0.180	C	VD3-1	24	6	VT RTE 114																						
SIGN SUMMARY SHEET							SHEET TOTALS			22.09	0.00	2	1	1	7	4	3	3	45									
							SF	SF	EA	EA	EA	EA	EA	EA	EA	EA	EA	EA	FT									
VERMONT AGENCY OF TRANSPORTATION							TOWN TOTALS			86.34	0.0	3.0	4.0	4.0	23.0	7.0	10.0	17	255.0									
												PROJECT NAME: STATEWIDE- NORTHEAST																
												PROJECT NUMBER: STPG SIGN(56)																
												FILE NAME: z15T007VT114-EAST HAVEN-N						PLOT DATE: 5/4/2016										
												PROJECT MANAGER: B. BRESLEND						DRAWN BY: O. DALMER										
												DESIGNED BY: O. DALMER						CHECKED BY: B. BRESLEND										
												EAST HAVEN VT114 NB 1						SHEET 144 OF 168										

11/9/16

11/7/16