
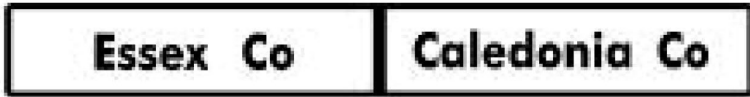
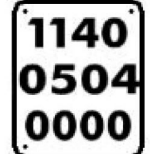
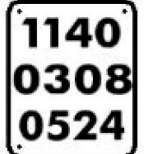






11/11/16

DIR	MILEPOINT	LOCATION CODE	MUTCD CODE	WIDTH	HEIGHT	SHEETING REMARKS	SIGN LEGEND	NEW SIGNS		EXISTING SIGNS				EXIST POST		NUMBER OF NEW POSTS	SQUARE STEEL (in)			TUBULAR STEEL Ø (IN)				SIGN FRAME REQUIRED	REMARKS	SIGN DETAIL		
								"A"	"B"	RETAIN	SALVAGE FROM	SALVAGE TO	REMOVE	RETAIN	REMOVE		1.75	2.00	2.50	3.00	3.50	4.00	5.00			DETAIL IN SHSM	DETAIL ON SHEET NUMBER	DETAIL ON STD SHEET NUMBER
																	(LB / FT)			(LB / FT)								
BRIGHTON			VT114	NB	FYG-FLUORESCENT YELLOW-GREEN																	"SHSM" - STANDARD HIGHWAY SIGNS AND MARKINGS						
NB	0.000	C	VD-024	72	10	BRIGHTON / NEWARK																						
		C	VD-025	72	10	ESSEX CO / CALEDONIA CO																						
		C	VD-700	6	10	MM 1140, 0504, 0000																						
		C	VD-700	6	10	MM 1140, 0308, 0524																						
		C	VD-024	72	10		5.00																			T-94		
		C	VD-025	72	10		5.00																				T-94	
		C	VD-700	6	10	 	0.42																				T-44	
		C	VD-700	6	10		0.42																				T-44	
NB	1.827	A	S3-1	30	30	SCHOOL BUS STOP AHEAD																					ADDED THIN & TRIM	
		A	W1-5R	30	30	RIGHT WINDING CURVES																						
		A	W13-1P	18	18	35 MPH																						
		A	W1-5R	30	30		6.25																				X	
		A	W7-3aP	24	18		3.00																				X	
NB	1.980	A	W1-2L	30	30		6.25																				X	
		A	W13-1P	18	18		2.25																				X	
SIGN SUMMARY SHEET							SHEET TOTALS		28.59	0.00	0	0	0	7	0	3	4	60										
VERMONT AGENCY OF TRANSPORTATION							SF	SF	EA	EA	EA	EA	EA	EA	EA	EA	EA	EA	FT									
							TOWN TOTALS		199.02	0.0	3.0	0.0	0.0	46.0	13.0	17.0	25	375.0										
												PROJECT NAME: STATEWIDE- NORTHEAST																
												PROJECT NUMBER: STPG SIGN(56)																
												FILE NAME: z15T007VT114-BRIGHTON-NB. PLOT DATE: 5/4/2016																
												PROJECT MANAGER: B. BRESLEND DRAWN BY: O. DALMER																
												DESIGNED BY: O. DALMER CHECKED BY: B. BRESLEND																
												BRIGHTON VT114 NB 1 SHEET 155 OF 168																

THIN & TRIM