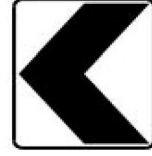
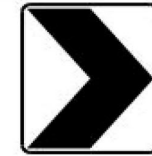

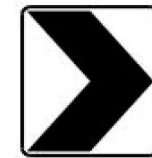

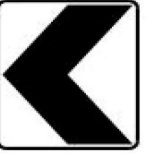



11/11/16

11/14/16

DIR	MILEPOINT	LOCATION CODE	MUTCD CODE	WIDTH	HEIGHT	SHEETING REMARKS	SIGN LEGEND	NEW SIGNS		EXISTING SIGNS				EXIST POST		NUMBER OF NEW POSTS	SQUARE STEEL (in)			TUBULAR STEEL Ø (IN)				SIGN FRAME REQUIRED	REMARKS	SIGN DETAIL		
								"A"	"B"	RETAIN	SALVAGE FROM	SALVAGE TO	REMOVE	RETAIN	REMOVE		1.75	2.00	2.50	3.00	3.50	4.00	5.00			DETAIL IN SHSM	DETAIL ON SHEET NUMBER	DETAIL ON STD SHEET NUMBER
																	(LB / FT)			(LB / FT)								
	<b>BRIGHTON</b>		<b>VT114</b>		<b>NB</b>		FYG-FLUORESCENT YELLOW-GREEN															"SHSM" - STANDARD HIGHWAY SIGNS AND MARKINGS						
		A	W1-8L	18	24			3.00							1								INSTALL CHEVRON PAIRS 5 FT APART. INSTALL CHEVRON PAIRS AT 120 FOOT SPACING.	X				
NB	2.494	B	W1-8R	18	24		CHEVRON																					
NB	2.495	B	W1-8R	18	24			3.00							1									INSTALL CHEVRON PAIRS 5 FT APART. INSTALL CHEVRON PAIRS AT 120 FOOT SPACING.	X			
NB	2.512	A	W1-8L	18	24		CHEVRON																					
NB	2.517	A	W1-8L	18	24			3.00							1									INSTALL CHEVRON PAIRS 5 FT APART. INSTALL CHEVRON PAIRS AT 120 FOOT SPACING.	X			
NB	2.512	B	W1-8R	18	24		CHEVRON																					
BN	2.518	B	W1-8R	18	24			3.00							1									INSTALL CHEVRON PAIRS 5 FT APART. INSTALL CHEVRON PAIRS AT 120 FOOT SPACING.	X			
NB	2.527	A	W1-8	18	24		CHEVRON																	BACK TO BACK				
		B	W1-8	18	24		CHEVRON																	BACK TO BACK				
NB	2.540	A	W1-8L	18	24			3.00							1									INSTALL CHEVRON PAIRS 5 FT APART. INSTALL CHEVRON PAIRS AT 120 FOOT SPACING.	X			
NB	2.541	B	W1-8R	18	24			3.00							1									INSTALL CHEVRON PAIRS 5 FT APART. INSTALL CHEVRON PAIRS AT 120 FOOT SPACING.	X			
NB	2.568	A	W1-5L	30	30		LEFT WINDING CURVES																					
		A	W13-1P	18	18		35 MPH																					
NB	2.648	A	VD-701	6	8		BRIDGE 23 VT 114																					
NB	2.795	A	W1-6L	48	24			8.00							2									LARGE ARROW INSTALL PRPOSED SIGN 200 FEET SOUTH OF EXISTING	X			
<b>SIGN SUMMARY SHEET</b>							SHEET TOTALS		26.00	0.00	1	0	0	7	1	5	8	120					PROJECT NAME: STATEWIDE- NORTHEAST PROJECT NUMBER: STPG SIGN(56)					
VERMONT AGENCY OF TRANSPORTATION							SF	SF	EA	EA	EA	EA	EA	EA	EA	EA	EA	EA	FT					FILE NAME: z15T007VT114-BRIGHTON-NB. PLOT DATE: 5/4/2016 PROJECT MANAGER: B. BRESLEND DRAWN BY: O. DALMER DESIGNED BY: O. DALMER CHECKED BY: B. BRESLEND BRIGHTON VT114 NB 3 SHEET 157 OF 168				
							TOWN TOTALS		199.02	0.0	3.0	0.0	0.0	46.0	13.0	17.0	25	375.0										