


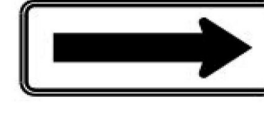

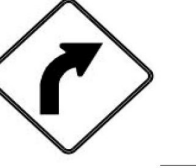



DIR	MILEPOINT	LOCATION CODE	MUTCD CODE	WIDTH	HEIGHT	SHEETING REMARKS	SIGN LEGEND	NEW SIGNS		EXISTING SIGNS				EXIST POST		NUMBER OF NEW POSTS	SQUARE STEEL (in)			TUBULAR STEEL Ø (IN)				SIGN FRAME REQUIRED	REMARKS	SIGN DETAIL		
								"A"	"B"	RETAIN	SALVAGE FROM	SALVAGE TO	REMOVE	RETAIN	REMOVE		(LB / FT)			(LB / FT)						DETAIL IN SHSM	DETAIL ON SHEET NUMBER	DETAIL ON STD SHEET NUMBER
																	1.75	2.00	2.50	3.00	3.50	4.00	5.00					
	BRIGHTON	VT114	SB				FYG-FLUORESCENT YELLOW-GREEN															"SHSM" - STANDARD HIGHWAY SIGNS AND MARKINGS						
	SB	2.659	F	W1-5R	30	30	RIGHT WINDING CURVES																					
			F	W13-1P	18	18	35 MPH																					
	SB	2.646	F	VD-701	6	8	BRIDGE 23 VT 114			1																		
	SB	2.570	F	W1-4R	30	30		6.25																				
			F	W13-1P	18	18		2.25																				
	SB	2.248	F	W1-6L	48	24	<--- LEFT																					
			F	W1-6L	48	24		8.00																				
	SB	2.218	E	W1-6R	48	24	RIGHT --->																					
			E	W1-6R	48	24		8.00																				
	SB	2.179	F	S3-1	30	30	SCHOOL BUS STOP AHEAD																					
			F	S3-1	36	36	FYG 	9.00																				
	SB	2.090	A	W1-2R	30	30		6.25																				
			A	W13-1P	18	18		2.25																				
	SB	2.075	F	VD-701	6	8	BRIDGE 22 VT 114			1																		
	SB	1.582	G	VR-017	24	30	LLL 24,000 LBS																					
SIGN SUMMARY SHEET							SHEET TOTALS	42.00	0.00	2	0	0	6	5	4	6	90											
VERMONT AGENCY OF TRANSPORTATION								SF	SF	EA	EA	EA	EA	EA	EA	EA	FT											
							TOWN TOTALS	160.00	0.0	8.0	0.0	0.0	35.0	14.0	14.0	22	330.0											
												PROJECT NAME: STATEWIDE- NORTHEAST																
												PROJECT NUMBER: STPG SIGN(56)																
												FILE NAME: z15T007VT114-BRIGHTON-SB: PLOT DATE: 5/4/2016																
												PROJECT MANAGER: B. BRESLEND DRAWN BY: O. DALMER																
												DESIGNED BY: O. DALMER CHECKED BY: B. BRESLEND																
												BRIGHTON VT114 SB 4 SHEET 165 OF 168																

11/11/16
11/14/16
11/11/16
11/14/16
11/11/16