

24 INCH STOP BAR, WATERBORNE PAINT
~~STA. 154+15.68, RT~~ PAINTED UNDER:
~~STA. 154+46.03, LT~~ WILLISTON NH 2949(1)
~~STA. 155+35.65, LT~~ PROJECT

TRAFFIC SIGNS, TYPE A

STA. 154+90.32, LT (EXISTING MA-2)(LEFT TURN YIELD ON FLASHING)

TRAFFIC CONTROL SIGNAL SYSTEM, INTERSECTION(VT ROUTE 2A & EXIT 12 SOUTHBOUND RAMPS)
 SEE LIST OF MAJOR EQUIPMENT, TRAFFIC SIGNAL LAYOUT SHEET 1B

CONSTRUCT CONTROLLER CABINET (GROUND MOUNTED)
 STA. 154+48.57, RT

REMOVAL OF TRAFFIC CONTROL SIGNAL SYSTEM (VT ROUTE 2A & EXIT 12 SOUTHBOUND RAMPS)
 SEE NOTE 2, THIS SHEET

SPECIAL PROVISION (LUMINAIRE, RETROFIT LED)
 STA. 154+43.47, RT
 STA. 154+90.32, LT





I-89 EXIT 12 SB OFF RAMP

VT ROUTE 2A TO ESSEX

I-89 SB

PHASING DIAGRAM

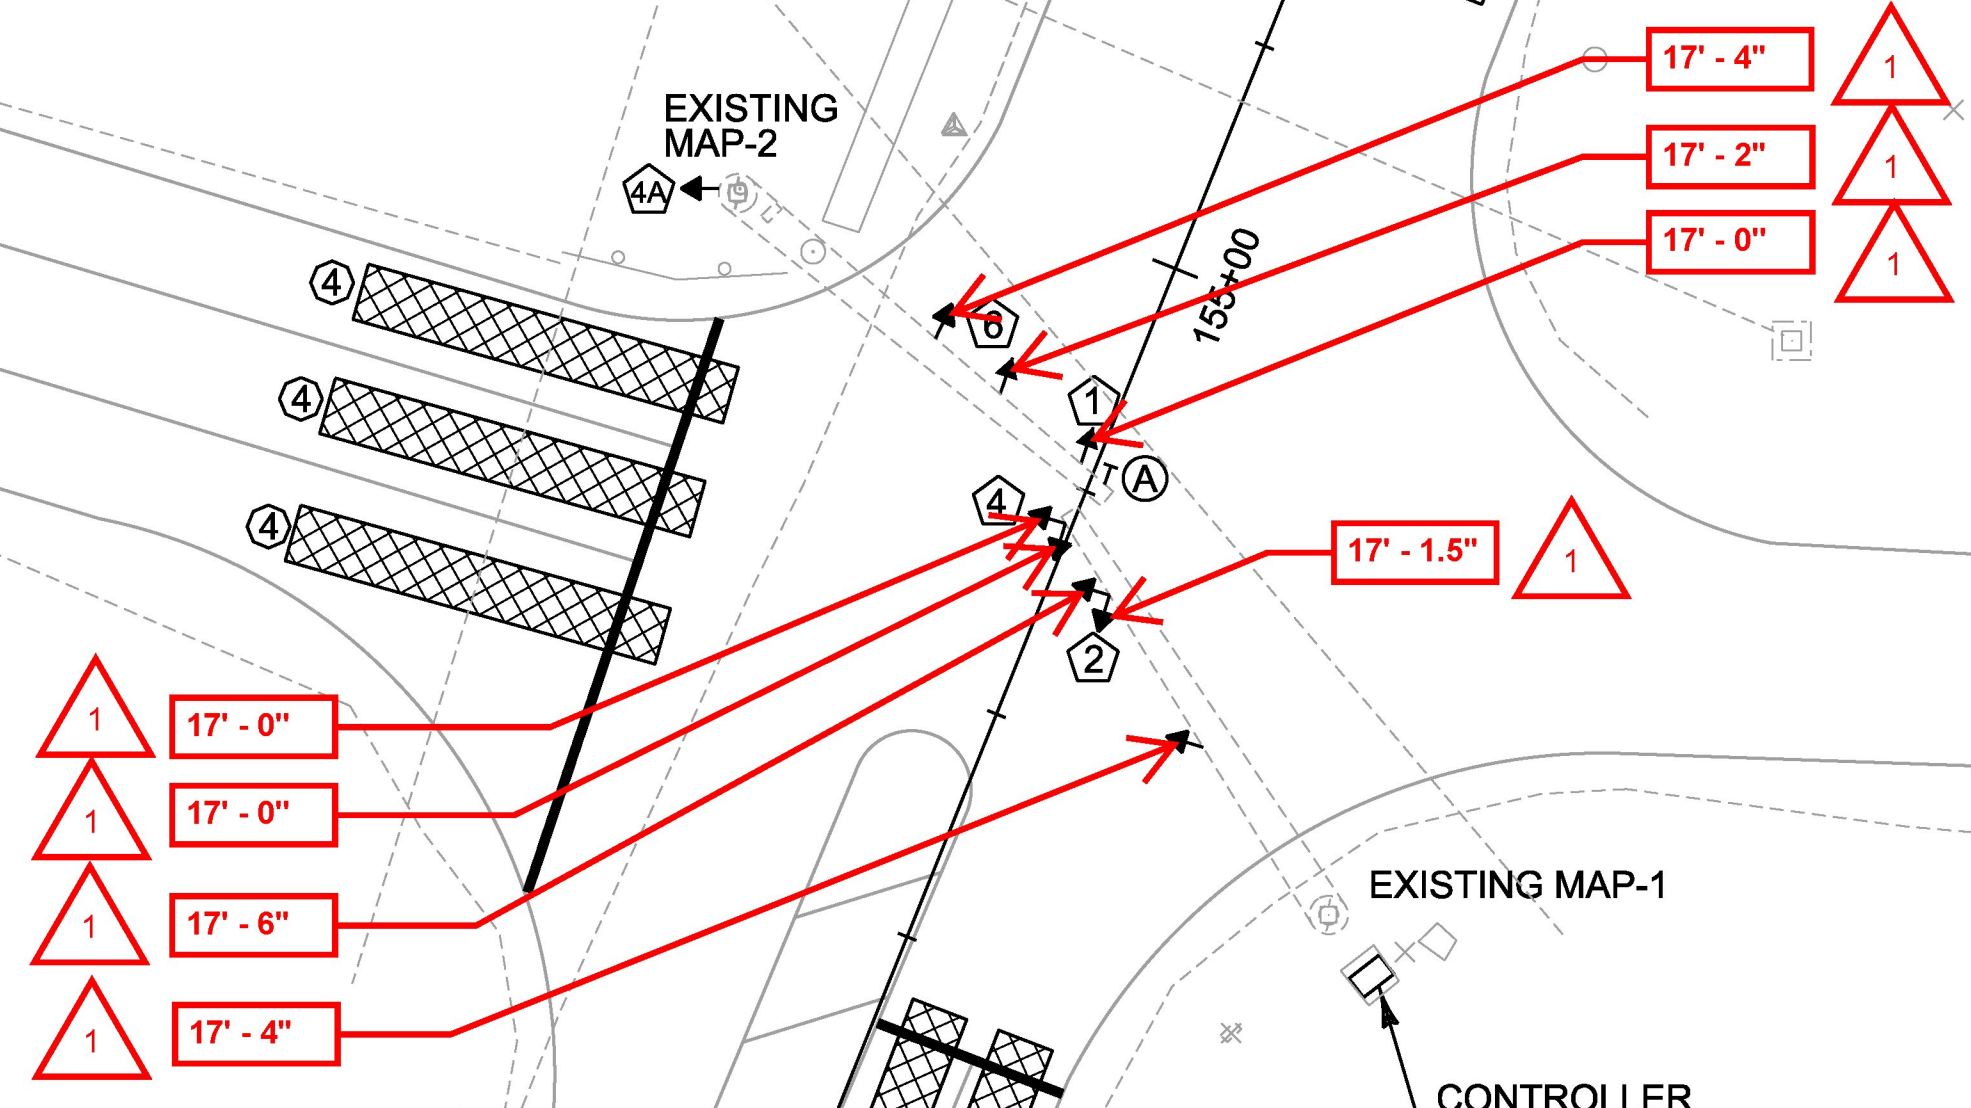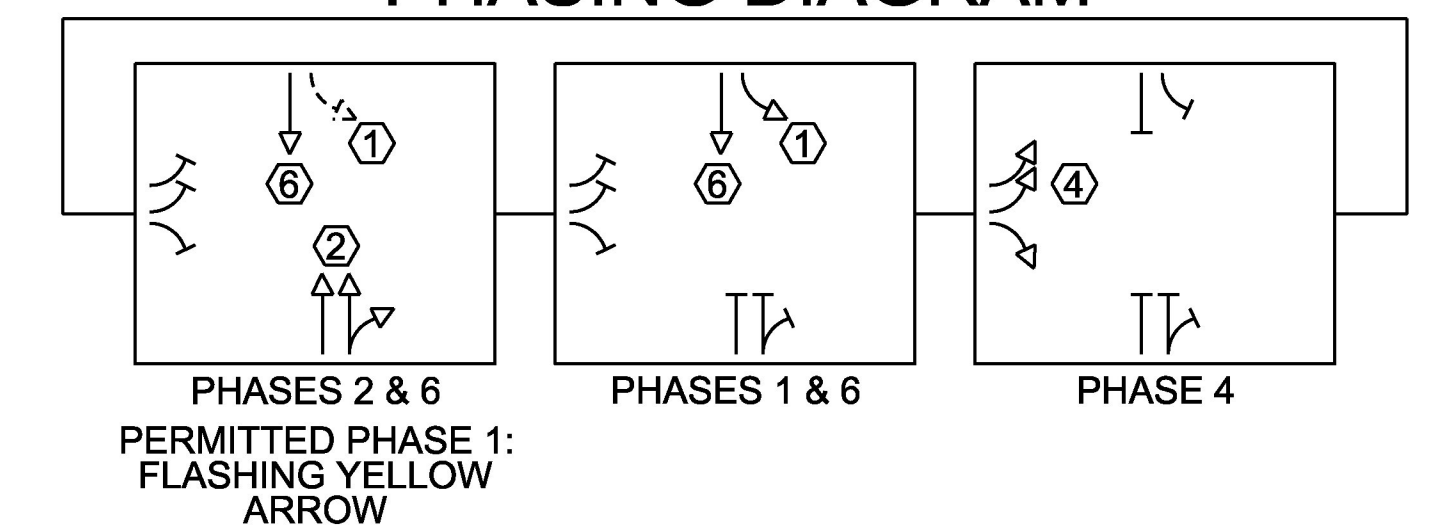

I-89 EXIT 12 SB ON RAMP

DETECTION ZONE	DETECTOR TYPE
1, 2, 4, 6	PRESENCE
A, AA	PULSE

SIGN DETAIL



(A)


TRAFFIC SIGNAL LEGEND	
□JB	JUNCTION BOX
□DJB	DOUBLE JUNCTION BOX
●PP	PEDESTRIAN PEDESTAL POST
→②	SIGNAL HEAD WITH PHASE NO.
→②	PEDESTRIAN SIGNAL HEAD WITH PED PHASE
---	WIRED CONDUIT
---	WIRED CONDUIT IN ELECTRICAL CONDUIT SLEEVE
—(A)	MAST ARM-MOUNTED SIGN
⊗	STOP BAR DETECTION AREA
⊗	ADVANCE DETECTION AREA

NOTES:

- ITEMS LISTED ARE APPROXIMATE LOCATIONS AND MAY BE MODIFIED BY THE ENGINEER IN THE FIELD.
- THE REMOVAL OF ALL EXISTING TRAFFIC SIGNAL EQUIPMENT THAT SHALL NOT BE REINSTALLED SHALL BE SALVAGED TO THE AGENCY OF TRANSPORTATION DISTRICT 5 SIGNAL TECHNICIAN, (802) 343-2188. WORK REQUIRED TO PERFORM THIS ACTIVITY SHALL BE PAID FOR UNDER CONTRACT ITEM 678.45 REMOVAL OF TRAFFIC CONTROL SIGNAL SYSTEM.
- FOR A LIST OF MAJOR EQUIPMENT AND CONTROLLER DATA, SEE TRAFFIC SIGNAL LAYOUT SHEET 1B.

NOTE: DISTANCE IS MEASURED BETWEEN THE BOTTOM OF SIGNAL HEAD TO THE PAVEMENT DIRECTLY BELOW THE SIGNAL HEAD.

PROPOSED SIGNAL FACE ARRANGEMENTS

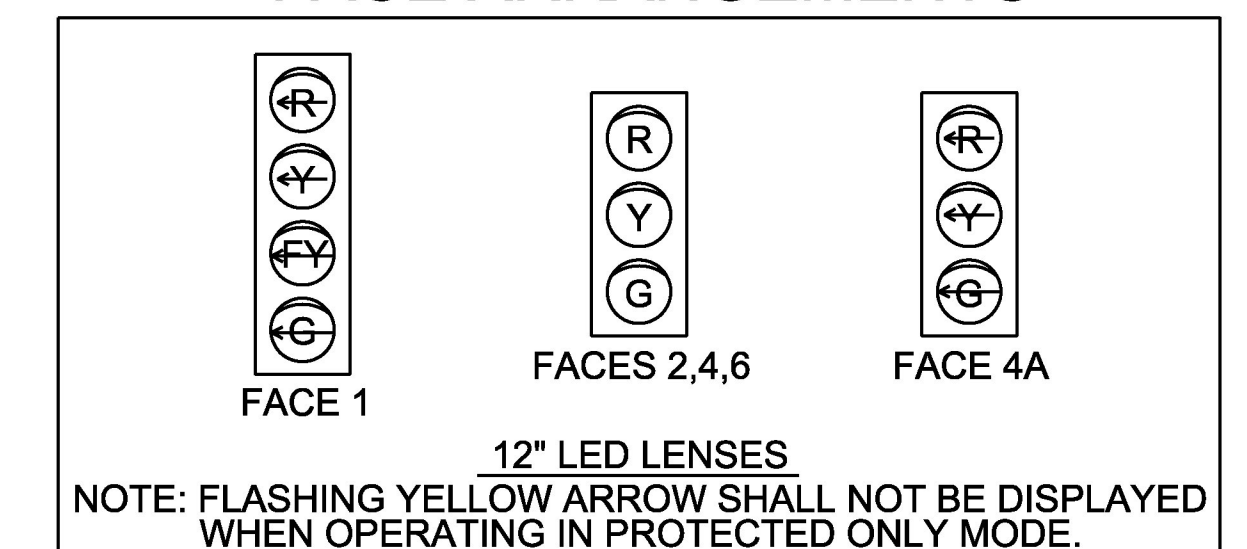

MS 570: VT ROUTE 2A & EXIT 12 SOUTHBOUND RAMPS

PROJECT NAME:	WILLISTON-ESSEX	FILE NAME:	t15i017sig.dgn	PLOT DATE:	3/21/2017
PROJECT NUMBER:	STPG SGNL(46)	PROJECT LEADER:	M. LACROIX	DRAWN BY:	K. RECORD
		DESIGNED BY:	K. RECORD	CHECKED BY:	M. LACROIX
		TRAFFIC SIGNAL LAYOUT SHEET 1A		SHEET	19 OF 66

