

24 INCH STOP BAR, WATERBORNE PAINT
 STA. 210+80.76, RT **VT 2A NB (22 LF)**
 STA. 211+25.89, LT **PAUL ST. (28 LF)**
 STA. 211+54.26, LT **PAUL ST.**
 STA. 211+33.08, RT **ZEPHYR RD (24 LF)**
 STA. 211+70.57, LT **VT 2A SB (26 LF)**

CROSSWALK MARKING, WATERBORNE PAINT
 STA. 210+94.29, LT - STA. 210+89.99, RT **(63 LF)**
 STA. 210+89.99, RT - STA. 211+52.05, RT **(69 LF)**
 STA. 210+98.31, LT - STA. 211+58.63, LT **(68 LF)**
 STA. 211+61.91, LT - STA. 211+58.63, RT **(55 LF)**

TRAFFIC SIGNS, TYPE A
 STA. 210+82.30, LT (EXISTING MA-2)(LEFT TURN YIELD ON FLASHING)
 STA. 211+66.37, RT (EXISTING MA-4)(LEFT TURN YIELD ON FLASHING)

REMOVING SIGNS
 STA. 210+82.30, LT (EXISTING MA-2)(LEFT TURN YIELD ON GREEN)
 STA. 211+66.37, RT (EXISTING MA-4)(LEFT TURN YIELD ON GREEN)

TRAFFIC CONTROL SIGNAL SYSTEM, INTERSECTION(VT ROUTE 2A & ZEPHYR ROAD)
 SEE LIST OF MAJOR EQUIPMENT, SHEET 4B

CONSTRUCT CONTROLLER CABINET (GROUND MOUNTED)
 STA. 210+97.11, RT

CONSTRUCT PEDESTRIAN SIGNAL HEADS

STA. 210+69.90, RT
 STA. 210+69.90, RT
 STA. 210+82.30, LT
 STA. 210+82.30, LT
 STA. 211+66.37, RT
 STA. 211+66.37, RT
 STA. 211+70.12, LT
 STA. 211+70.12, LT

CONSTRUCT PEDESTRIAN PEDESTAL POLE
 STA. 210+69.90, RT (PP-7)

CONSTRUCT LED BLANK OUT SIGN


STA. 210+82.30, LT (EXISTING MA-4)
 STA. 210+97.34, RT (EXISTING MA-1)
 STA. 211+66.37, RT (EXISTING MA-2)
 STA. 211+70.12, LT (EXISTING MA-3)

REMOVAL OF TRAFFIC CONTROL SIGNAL SYSTEM (VT ROUTE 2A & ZEPHYR ROAD)
 SEE NOTE 2, THIS SHEET



SPECIAL PROVISION (LUMINAIRE, RETROFIT LED)

STA. 210+82.30, LT
 STA. 211+64.11, RT

PHASING DIAGRAM

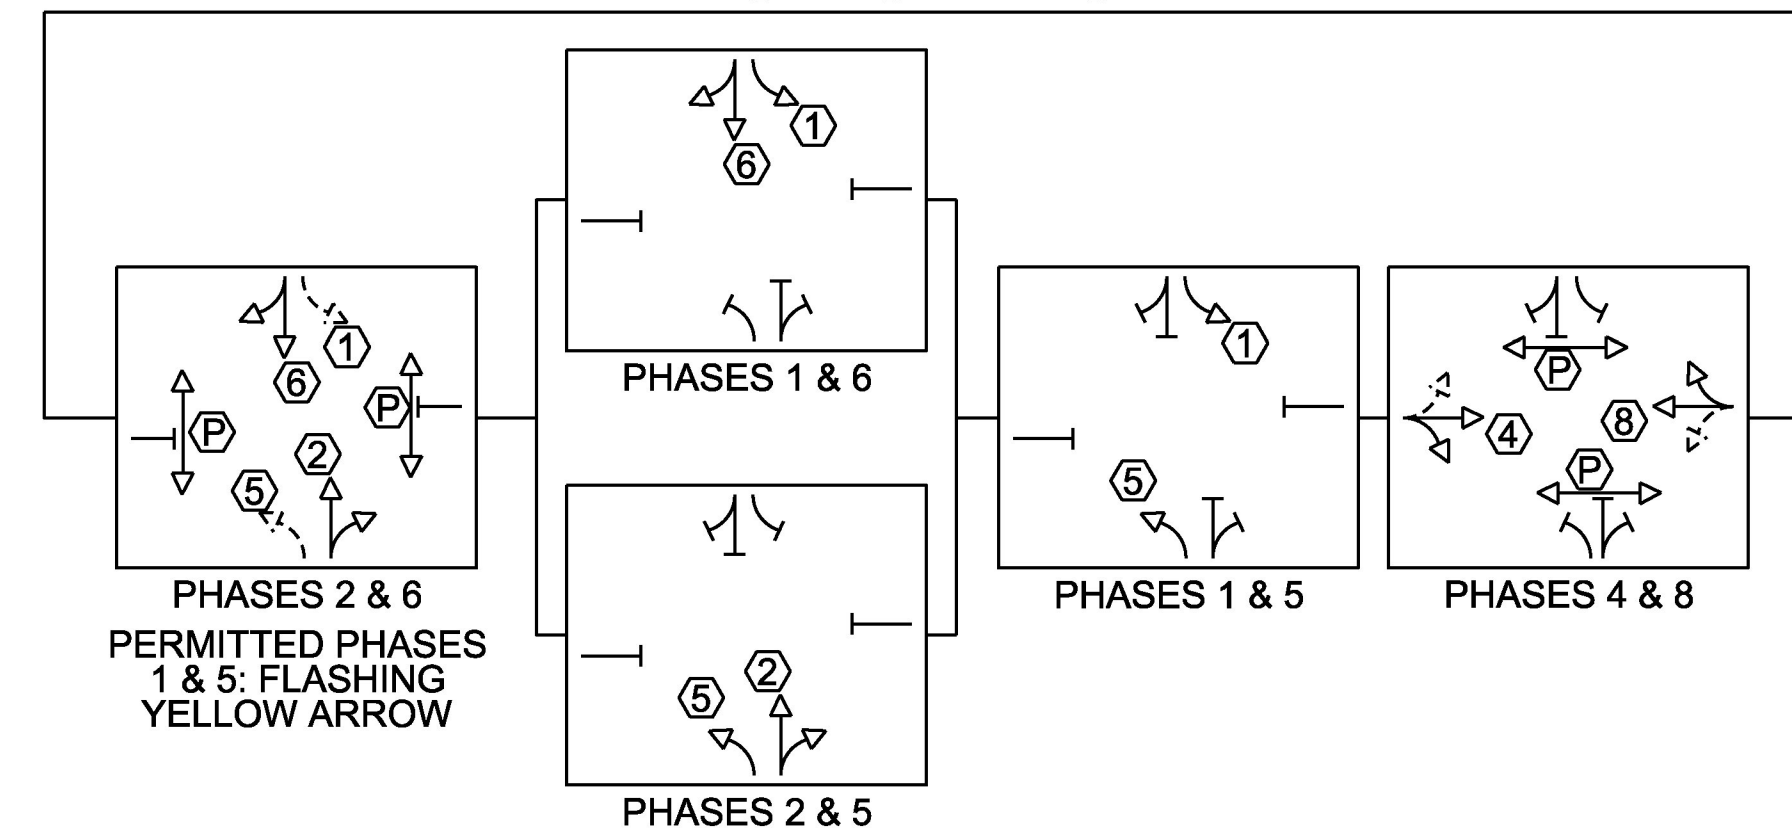


PROPOSED SIGNAL FACE ARRANGEMENTS

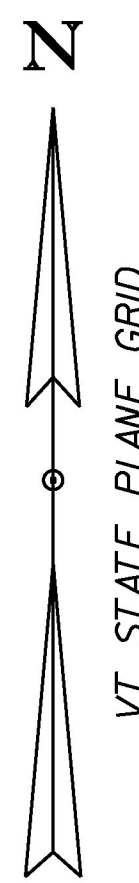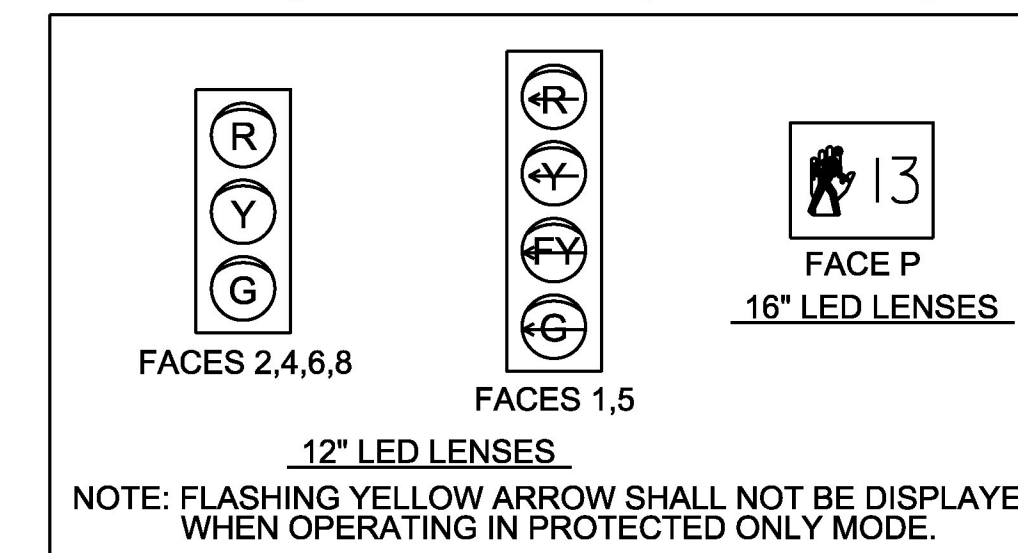

DETECTION ZONE	DETECTOR TYPE
1, 2, 4, 5, 6, 8	PRESENCE
D, DD	PULSE


SIGN DETAIL

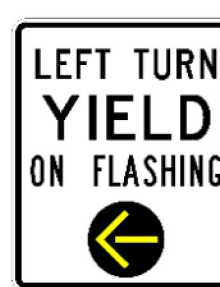

(A)

(B)

TRAFFIC SIGNAL LEGEND	
□ JB	JUNCTION BOX
□ D JB	DOUBLE JUNCTION BOX
● PP	PEDESTRIAN PEDESTAL POST
→ ②	SIGNAL HEAD WITH PHASE NO.
→ ②	PEDESTRIAN SIGNAL HEAD WITH PED PHASE
---	WIRED CONDUIT
---	WIRED CONDUIT IN ELECTRICAL CONDUIT SLEEVE
→ (A)	MAST ARM-MOUNTED SIGN
⊠	STOP BAR DETECTION AREA
⊠	ADVANCE DETECTION AREA

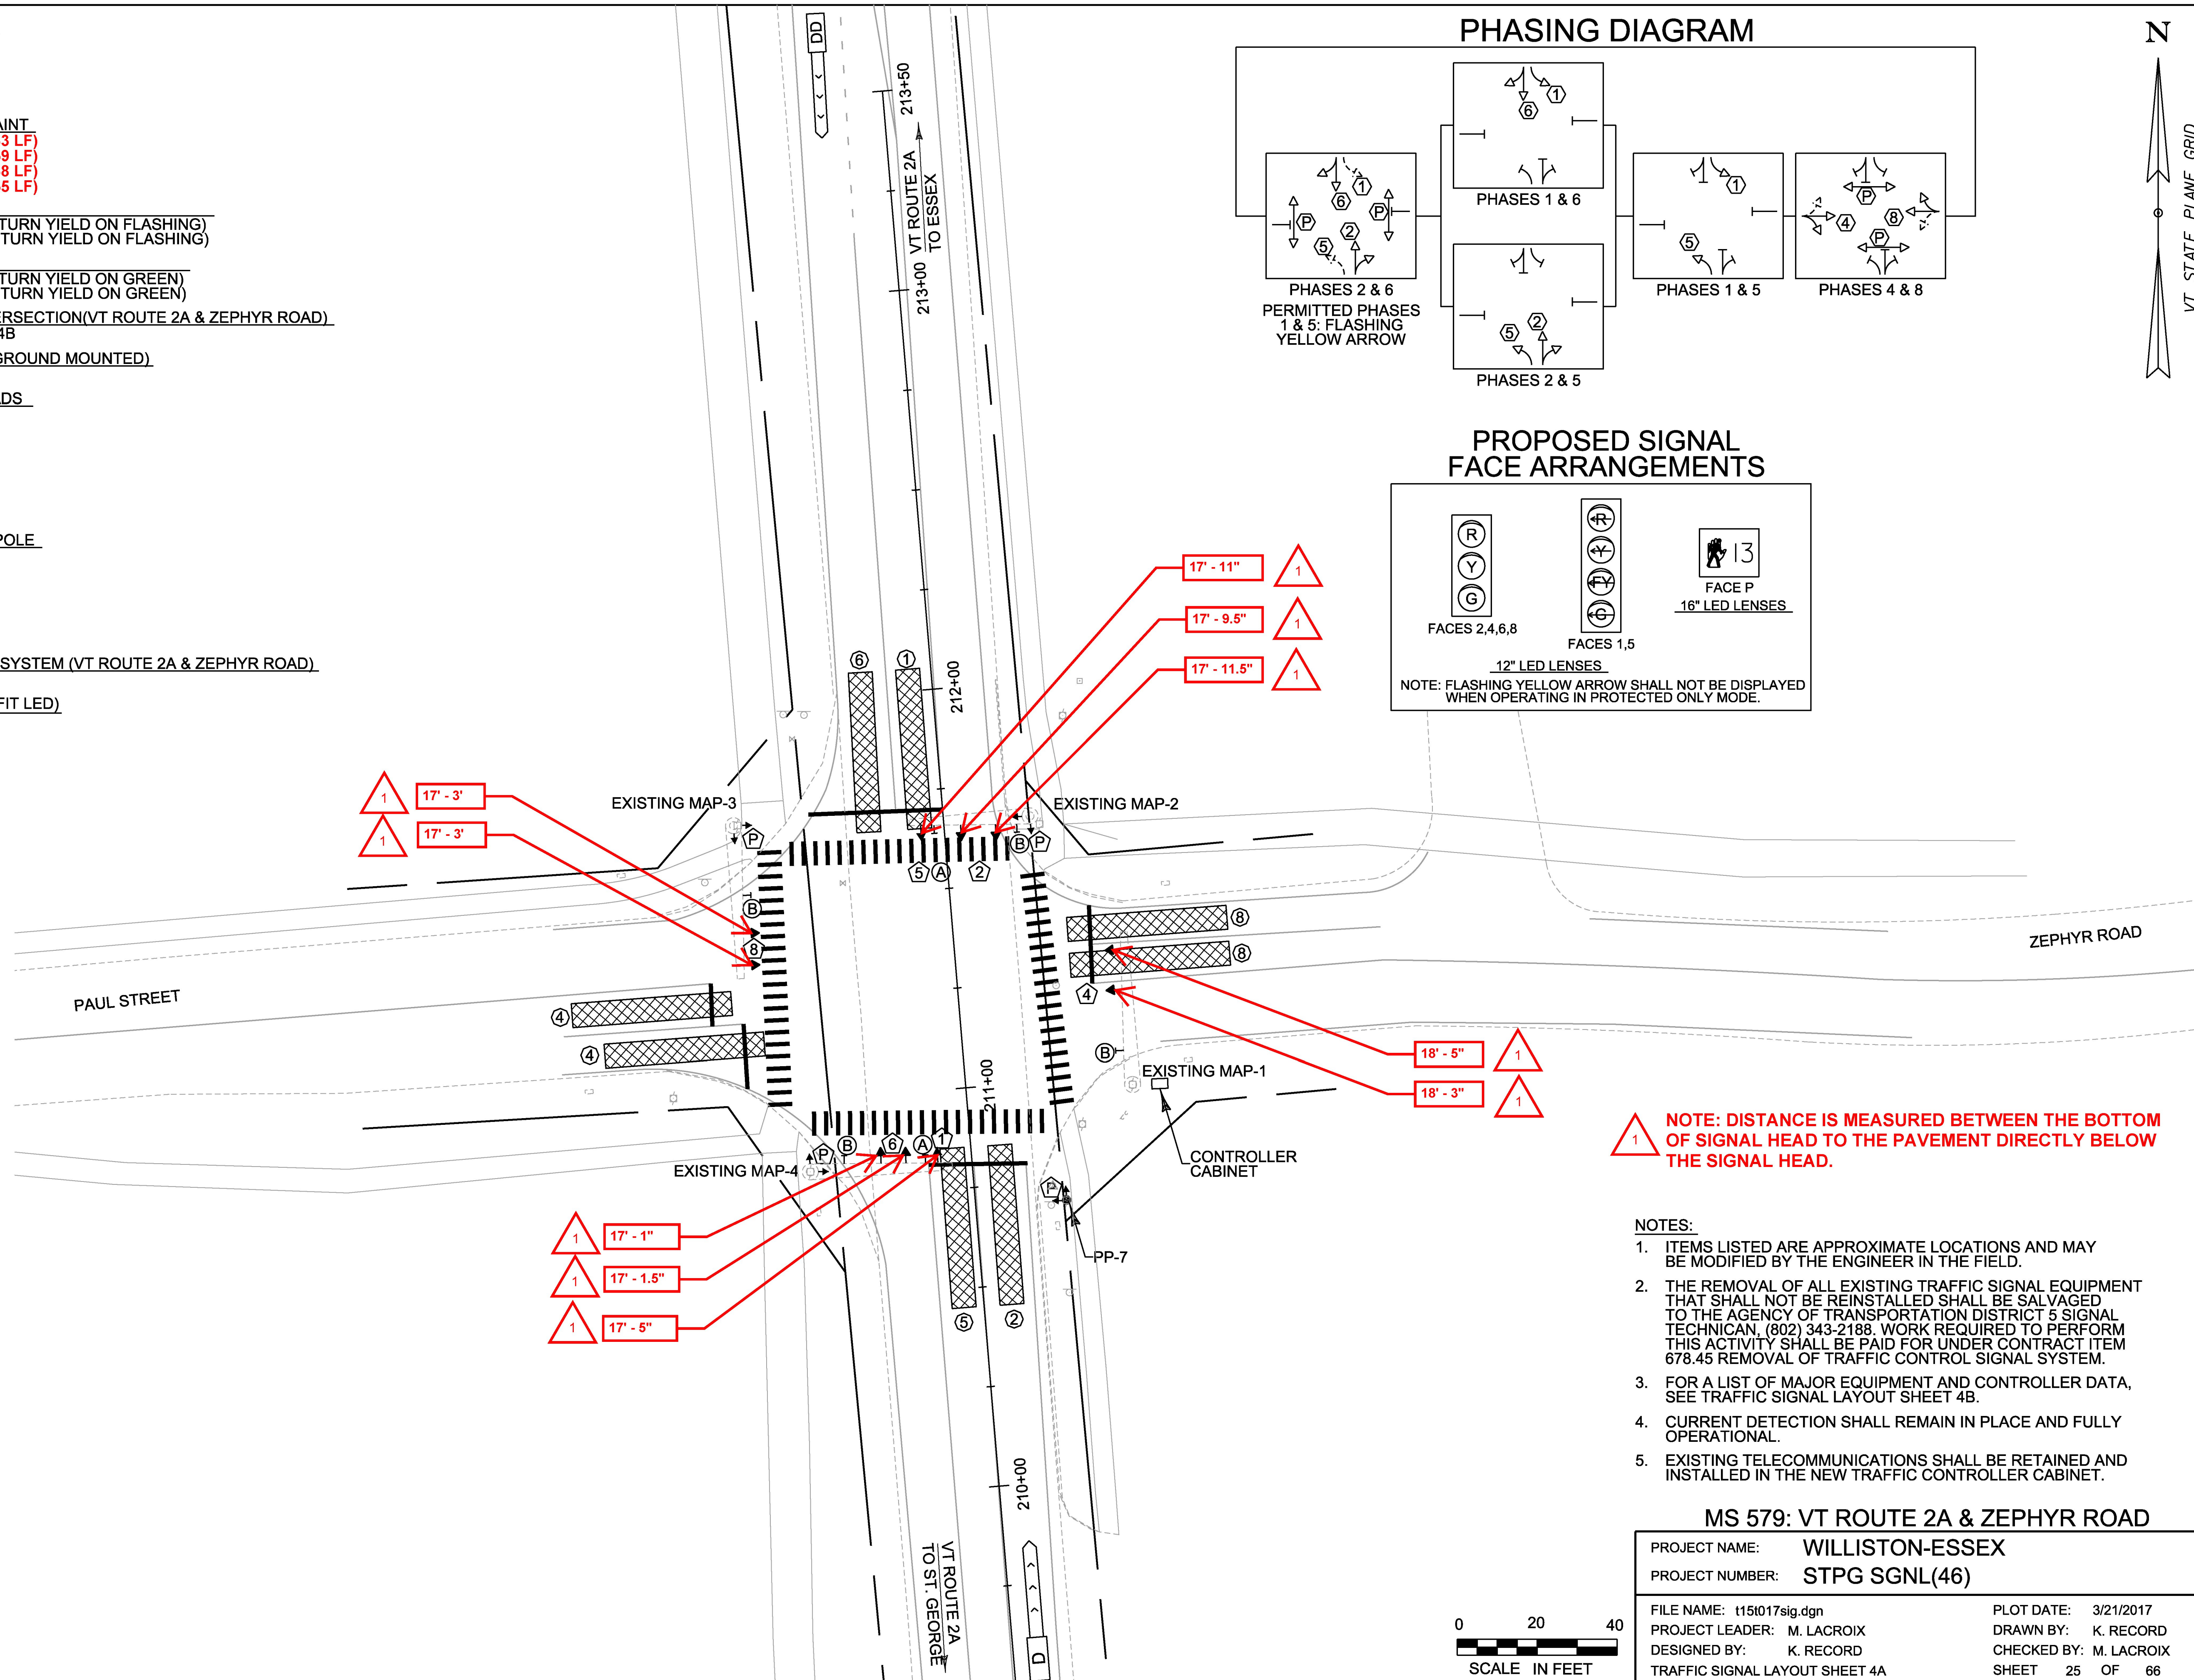

NOTE: DISTANCE IS MEASURED BETWEEN THE BOTTOM OF SIGNAL HEAD TO THE PAVEMENT DIRECTLY BELOW THE SIGNAL HEAD.

- NOTES:**
- ITEMS LISTED ARE APPROXIMATE LOCATIONS AND MAY BE MODIFIED BY THE ENGINEER IN THE FIELD.
 - THE REMOVAL OF ALL EXISTING TRAFFIC SIGNAL EQUIPMENT THAT SHALL NOT BE REINSTALLED SHALL BE SALVAGED TO THE AGENCY OF TRANSPORTATION DISTRICT 5 SIGNAL TECHNICIAN, (802) 343-2188. WORK REQUIRED TO PERFORM THIS ACTIVITY SHALL BE PAID FOR UNDER CONTRACT ITEM 678.45 REMOVAL OF TRAFFIC CONTROL SIGNAL SYSTEM.
 - FOR A LIST OF MAJOR EQUIPMENT AND CONTROLLER DATA, SEE TRAFFIC SIGNAL LAYOUT SHEET 4B.
 - CURRENT DETECTION SHALL REMAIN IN PLACE AND FULLY OPERATIONAL.
 - EXISTING TELECOMMUNICATIONS SHALL BE RETAINED AND INSTALLED IN THE NEW TRAFFIC CONTROLLER CABINET.

MS 579: VT ROUTE 2A & ZEPHYR ROAD

PROJECT NAME:	WILLISTON-ESSEX	FILE NAME:	t15i017sig.dgn	PLOT DATE:	3/21/2017
PROJECT NUMBER:	STPG SGNL(46)	PROJECT LEADER:	M. LACROIX	DRAWN BY:	K. RECORD
		DESIGNED BY:	K. RECORD	CHECKED BY:	M. LACROIX
		TRAFFIC SIGNAL LAYOUT SHEET 4A		SHEET	25 OF 66

