
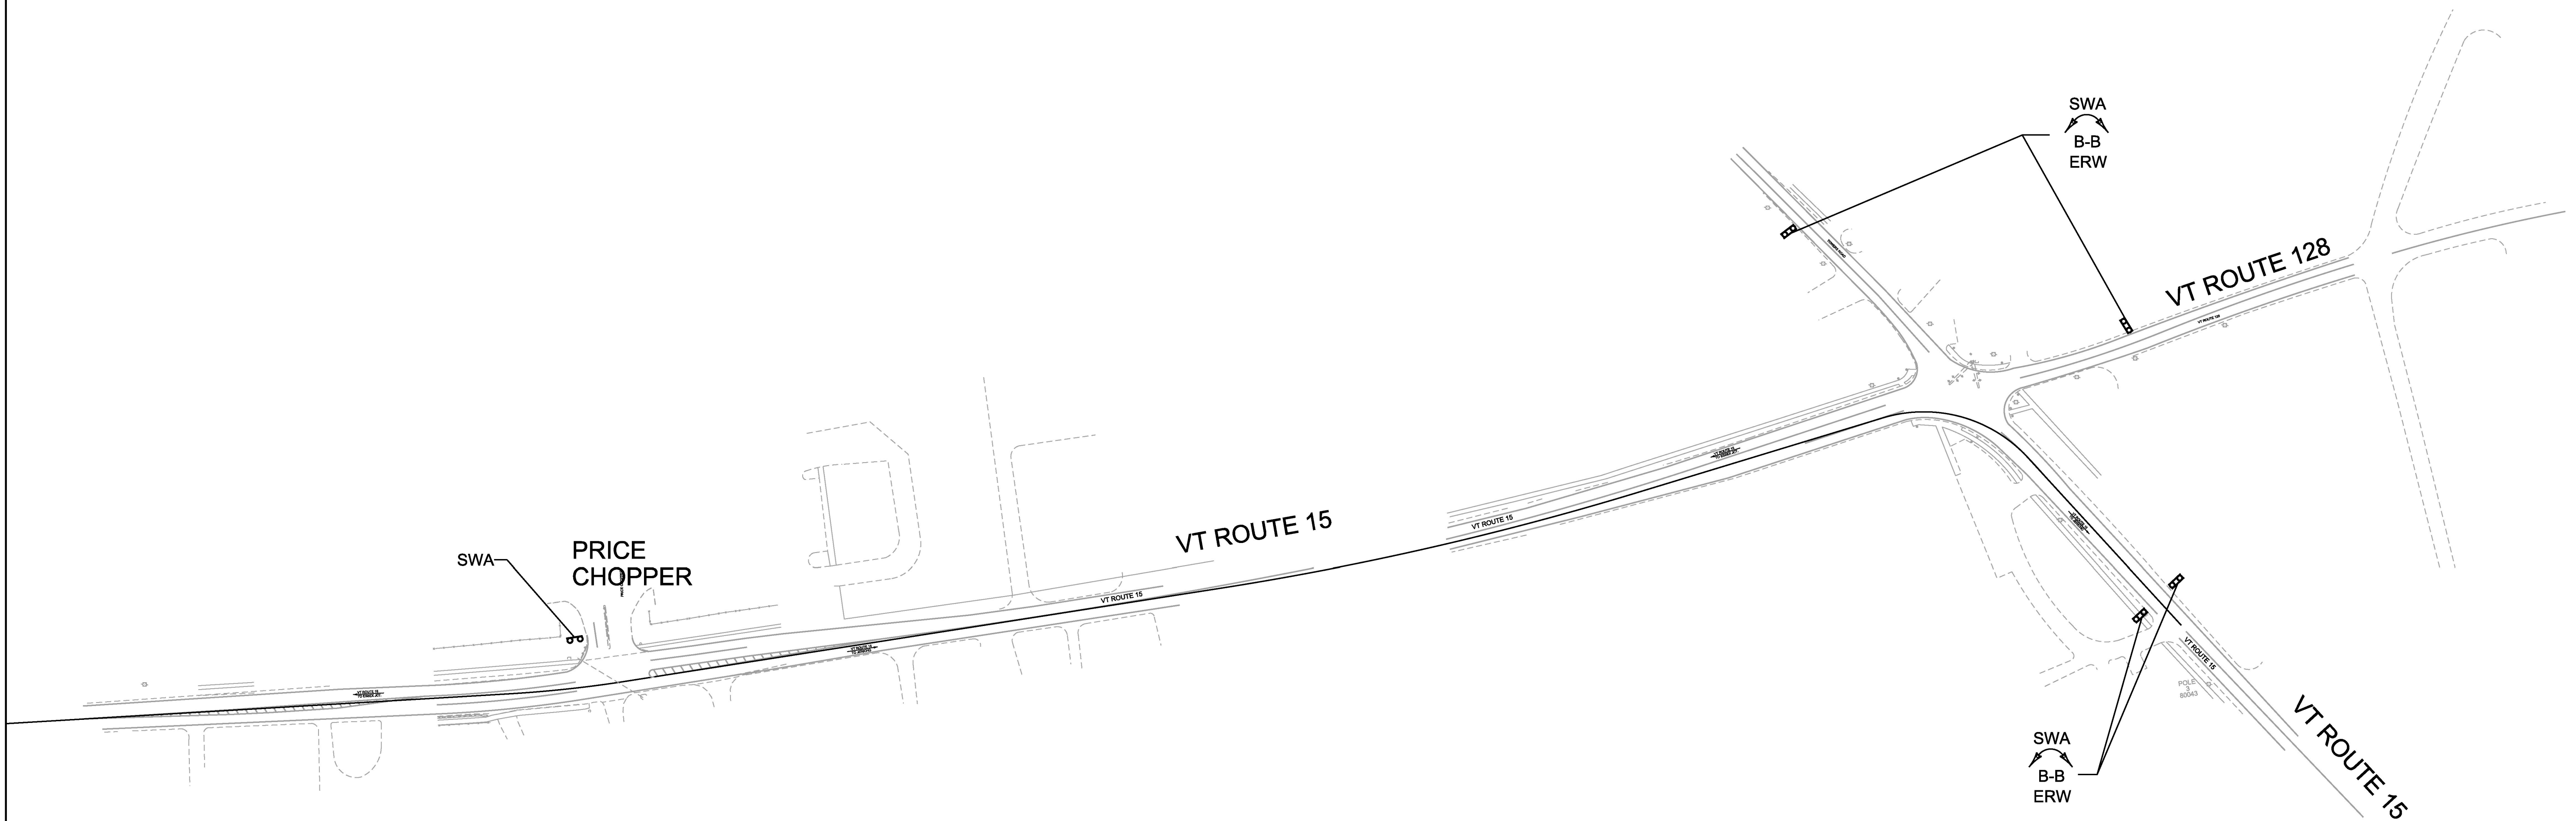



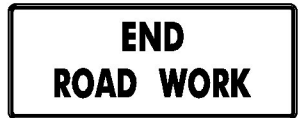
TRAFFIC CONTROL NOTES:
 SEE CONSTRUCTION APPROACH SIGNING SHEET 1 FOR NOTES.

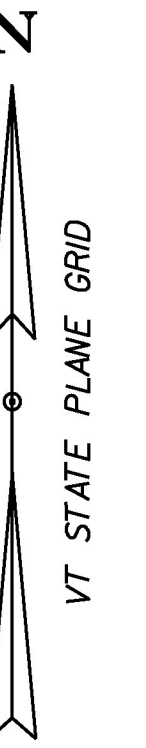

LEGEND

SWA = 

48" X 48"
 FLUORESCENT ORANGE BACKGROUND
 BLACK TEXT, LEGEND AND BORDER

ERW = 

PROJECT NAME:	WILLISTON-ESSEX
PROJECT NUMBER:	STPG SGNL(46)
FILE NAME: t15i017tcp.dgn	PLOT DATE: 3/21/2017
PROJECT LEADER: M. LACROIX	DRAWN BY: K. RECORD
DESIGNED BY: K. RECORD	CHECKED BY: M. LACROIX
CONSTRUCTION APPROACH SIGNING SHEET 3	SHEET 66 OF 66

NOT TO SCALE