

**INDEX OF SHEETS**

1.	TITLE SHEET
2.	QUANTITY SHEET
3.	TRAFFIC CONTROL PLAN
4.	MISCELLANEOUS DETAILS SHEET
5-11	ROUTE QUANTITY SHEETS 1-7
12.	ROUTE SUMMARY SHEET

**STANDARDS LIST**

E-192	10/12/2000
E-193	8/18/1995
T-1	8/6/2012
T-11	8/6/2012
T-12	8/6/2012
T-22	8/6/2012
T-23	8/6/2012
T-24	8/6/2012
T-28	8/6/2012
T-29	8/6/2012
T-31	8/6/2012


# STATE OF VERMONT AGENCY OF TRANSPORTATION




## PROPOSED IMPROVEMENT STATEWIDE - NORTH REGION NATIONAL HIGHWAY SYSTEM, STATE ROAD AND CLASS 1 TOWN HIGHWAYS

APPLICATION OF CENTER LINE, EDGE LINE AND LANE LINE MARKINGS ON NATIONAL HIGHWAY AND STATE SYSTEM ROADS AND CENTER LINE MARKINGS ON CLASS 1 TOWN HIGHWAYS WITHIN CALEDONIA, CHITTENDEN, ESSEX, FRANKLIN, GRAND ISLE, LAMOILLE, ORANGE, ORLEANS, AND WASHINGTON COUNTIES.

LENGTH OF PROJECT = 1375.651 MI = 7,263,437.28 LF

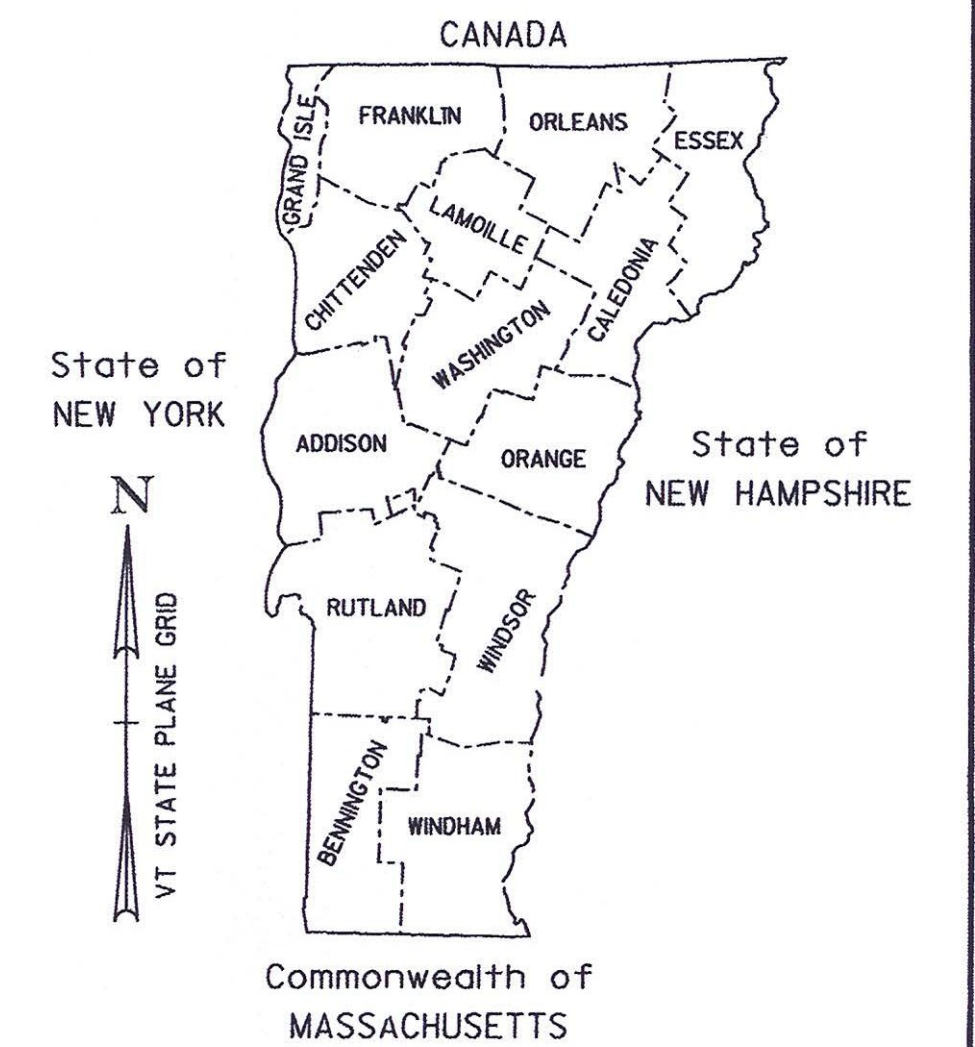

RECORD PLANS	
CONTRACTOR:	HI-WAY SAFETY SYSTEMS, INC. - ROCKLAND, MA
RESIDENT ENGINEER:	JOHN SLADYK
CONSTRUCTION BEGAN:	JUNE 13, 2016
CONSTRUCTION COMPLETE:	SEPTEMBER 28, 2016
RECORD PLANS BY:	JOHN SLADYK & JESSE IVES
I HEREBY CERTIFY THAT ALL THE CONSTRUCTION REQUIRED BY THIS SET OF DRAWINGS HAS BEEN ACCOMPLISHED AS INDICATED HEREIN.	
BY	RESIDENT ENGINEER
DATE	12-11-17
NOTE: Any further information concerning final quantities, amounts or other details relative to this project may be found at Central Files in the electronic archives.	

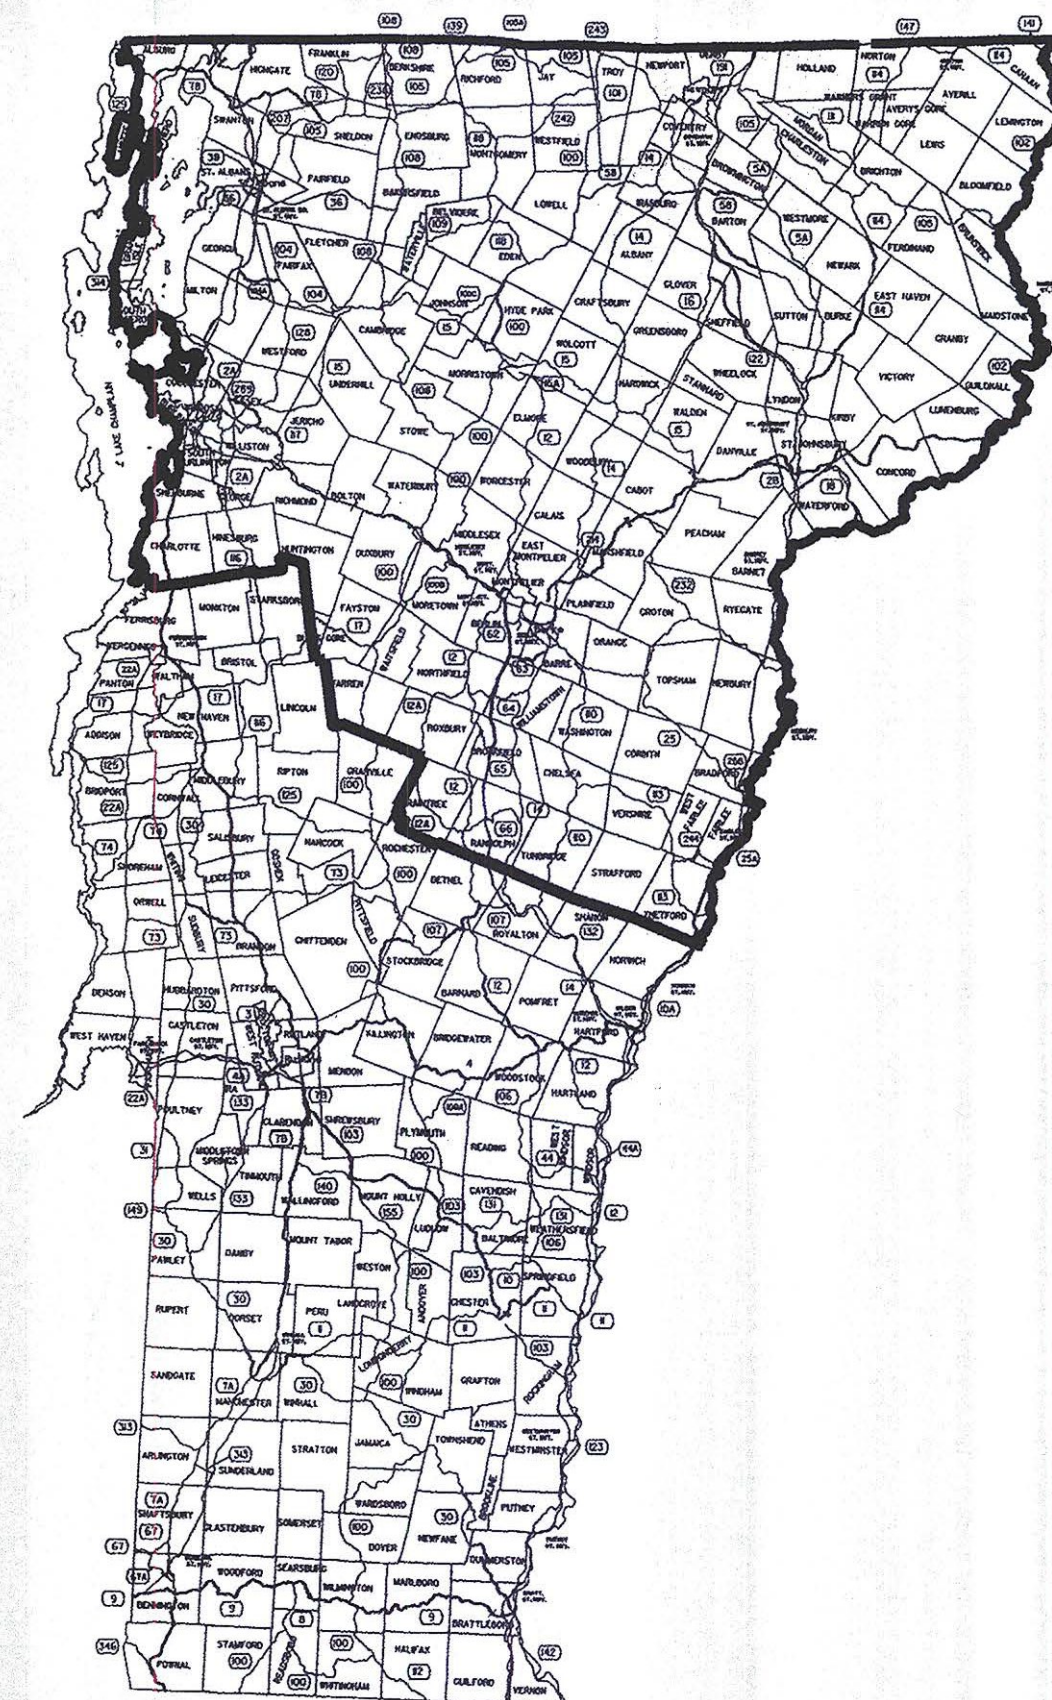

CONSTRUCTION IS TO BE CARRIED ON IN ACCORDANCE WITH THESE PLANS AND THE STANDARD SPECIFICATIONS FOR CONSTRUCTION DATED 2011, AS APPROVED BY THE FEDERAL HIGHWAY ADMINISTRATION ON JULY 20, 2011 FOR USE ON THIS PROJECT, INCLUDING ALL SUBSEQUENT REVISIONS AND SUCH REVISED SPECIFICATIONS AND SPECIAL PROVISIONS AS ARE INCORPORATED IN THESE PLANS.

QUALITY ASSURANCE PROGRAM : LEVEL I	
SURVEYED BY :	N/A
SURVEYED DATE :	N/A
DATUM	
VERTICAL	N/A
HORIZONTAL	N/A

**BUILT AS DESIGNED**

DIRECTOR OF PROJECT DELIVERY	
APPROVED	DATE 2/22/2016
PROJECT MANAGER :	PATRICIA COBURN P.E.
PROJECT NAME :	STATEWIDE - NORTH REGION
PROJECT NUMBER :	STPG MARK(304)
SHEET 1 OF 12 SHEETS	