

CHAIN-LINK FENCE, 4FT (VINYL COATED - BLACK)
(PAINT POSTS - BLACK)
STA 17+42, 39.6' RT TO STA 17+90, 39.6' RT
STA 17+42, 27.5' LT TO STA 17+83, 27.5' LT

COLD PLANING, BITUMINOUS PAVEMENT
STA 14+50 TO STA 19+75

SPECIAL PROVISION (STAMPED CONCRETE ISLAND, 8')
STA 1+38.8, LT TO STA 2+15.6, LT

EXCAVATION OF SURFACES AND PAVEMENTS
STA 100+19. , LT TO STA 101+26.3, LT
STA 100+20.4, RT TO STA 101+45.4, RT

REMOVE AND RESET GUARD RAIL
STA 14+81.25, RT TO STA 18+39.44, RT
STA 100+21.4, LT TO STA 100+90.0, LT

8 INCH UNDERDRAIN PIPE
STA 16+89.42, 44.6' RT TO
STA 17+00.15, 47.9' RT

DELINEATOR
STA 16+23, RT

REMOVAL OF EXISTING FENCE
STA 17+42.9, RT TO STA 17+89.9, RT
STA 17+42.9, LT TO STA 17+89.9, LT


TRANSPLANTING GROUNDCOVER
(WITHIN SLOPE LIMITS)
STA 1+48, LT TO STA 2+25, LT

TRANSPLANTING SHRUBS
(WITHIN SLOPE LIMITS)
STA 17+83, RT TO STA 18+14, RT

TRANSPLANTING TREES
STA 17+25, 60.0' RT

LIMIT OF WORK
MATCH EXISTING
STA 101+67.50

SPECIAL PROVISION (VERTICAL GRANITE CURB, MOUNTABLE)									
CURB ID	TYPE	STATION		OFFSET		LOCATION		RADIUS	LENGTH
		STATION	OFFSET	LOCATION	STATION	OFFSET	LOCATION		
SPLITTER ISLAND CURBING									
G-1	VERTICAL	2+17.36	19.23	LT	1+69.54	22.39	LT	340	22.53
G-2	VERTICAL	1+69.54	22.39	LT	1+39.66	56.88	LT	28	49.83
G-3	VERTICAL	1+39.66	56.88	LT	1+50.08	96.07	LT	STRAIGHT	38.86

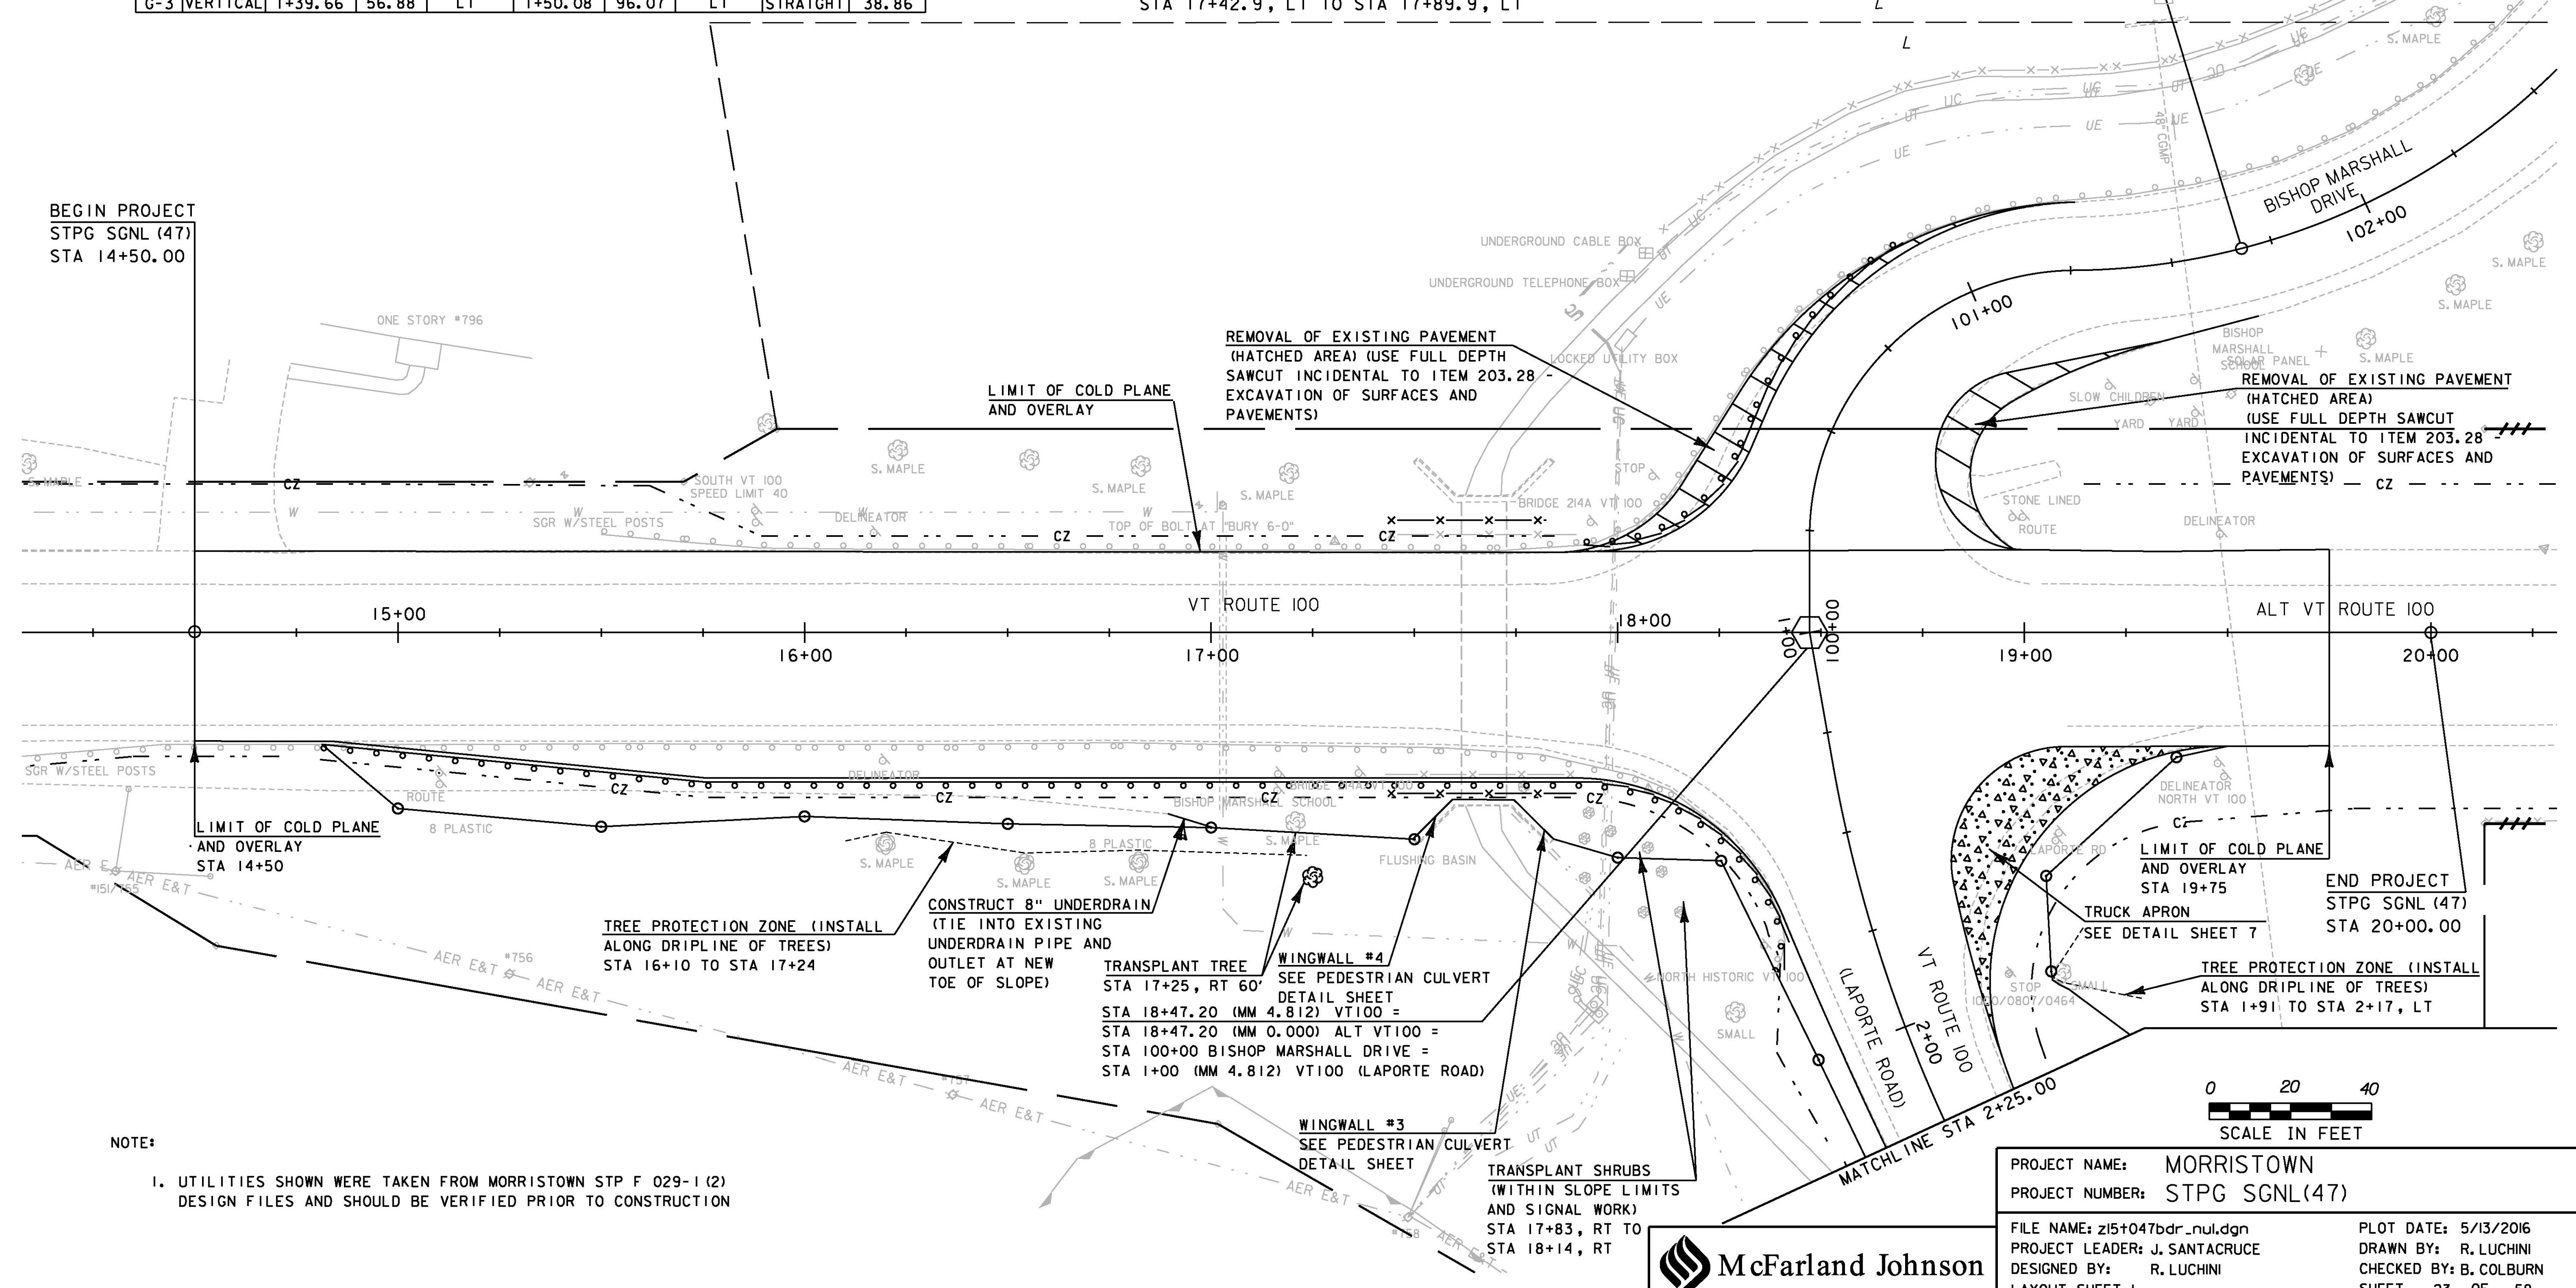

BEGIN PROJECT
STPG SGNL (47)
STA 14+50.00

END PROJECT
STPG SGNL (47)
STA 20+00.00

NOTE:
1. UTILITIES SHOWN WERE TAKEN FROM MORRISTOWN STP F 029-1 (2)
DESIGN FILES AND SHOULD BE VERIFIED PRIOR TO CONSTRUCTION

PROJECT NAME: MORRISTOWN	FILE NAME: z15+047bdr_nul.dgn	PLOT DATE: 5/13/2016
PROJECT NUMBER: STPG SGNL(47)	PROJECT LEADER: J. SANTACRUCE	DRAWN BY: R. LUCHINI
	DESIGNED BY: R. LUCHINI	CHECKED BY: B. COLBURN
	LAYOUT SHEET 1	SHEET 23 OF 58

