

EXISTING SIDEWALK SURFACE TO BE REMOVED PRIOR TO REGRADING ROADWAY. REGRADING WILL BE CONSIDERED INCIDENTAL TO SUBBASE OF DENSE GRADED CRUSHED STONE.


COLD PLANING
 STA 5+08.55 TO STA 5+58.55
 SEE MATERIAL TRANSITION DETAIL ON SHEET 6

EXCAVATION OF SURFACES AND PAVEMENTS
 STA 2+50, RT TO STA 2+78, RT (SIDEWALK AREA)
 BITUMINOUS CONCRETE SIDEWALK
 STA 2+50, RT TO STA 2+78, RT

LIMIT OF WORK
 MATCH EXISTING
 STA 5+58.55


TREE PROTECTION ZONE
 (INSTALL ALONG THE DRIPLINE OF TREES)
 STA 2+75 TO STA 4+03, LT

TREE PROTECTION ZONE (INSTALL ALONG DRIPLINE OF TREES)
 STA 2+25 TO STA 3+83, RT

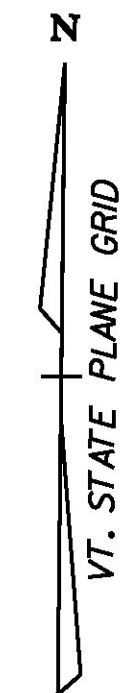

NOTE:

1. UTILITIES SHOWN WERE TAKEN FROM MORRISTOWN STP F 029-1 (2) DESIGN FILES AND SHOULD BE VERIFIED PRIOR TO CONSTRUCTION

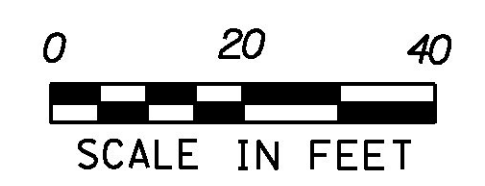

PROJECT NAME: MORRISTOWN	PLOT DATE: 5/13/2016
PROJECT NUMBER: STPG SGNL(47)	DRAWN BY: R. LUCHINI
FILE NAME: z15+047bdr_nul.dgn	CHECKED BY: B. COLBURN
PROJECT LEADER: J. SANTACRUCE	SHEET 24 OF 58
DESIGNED BY: R. LUCHINI	
LAYOUT SHEET 2	