



VT ROUTE 100  
 (LAPORTE ROAD)  
 CURVE (1)  
 DELTA = 49° 48' 22"  
 D = 16° 01' 19"  
 R = 357.61'  
 T = 166.02'  
 L = 310.86'  
 E = 36.66'

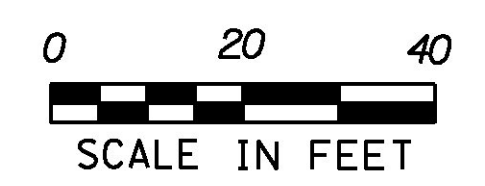

DATUM	
VERTICAL	NAVD 88
HORIZONTAL	NAD 83(92)
ADJUSTMENT	COMPASS

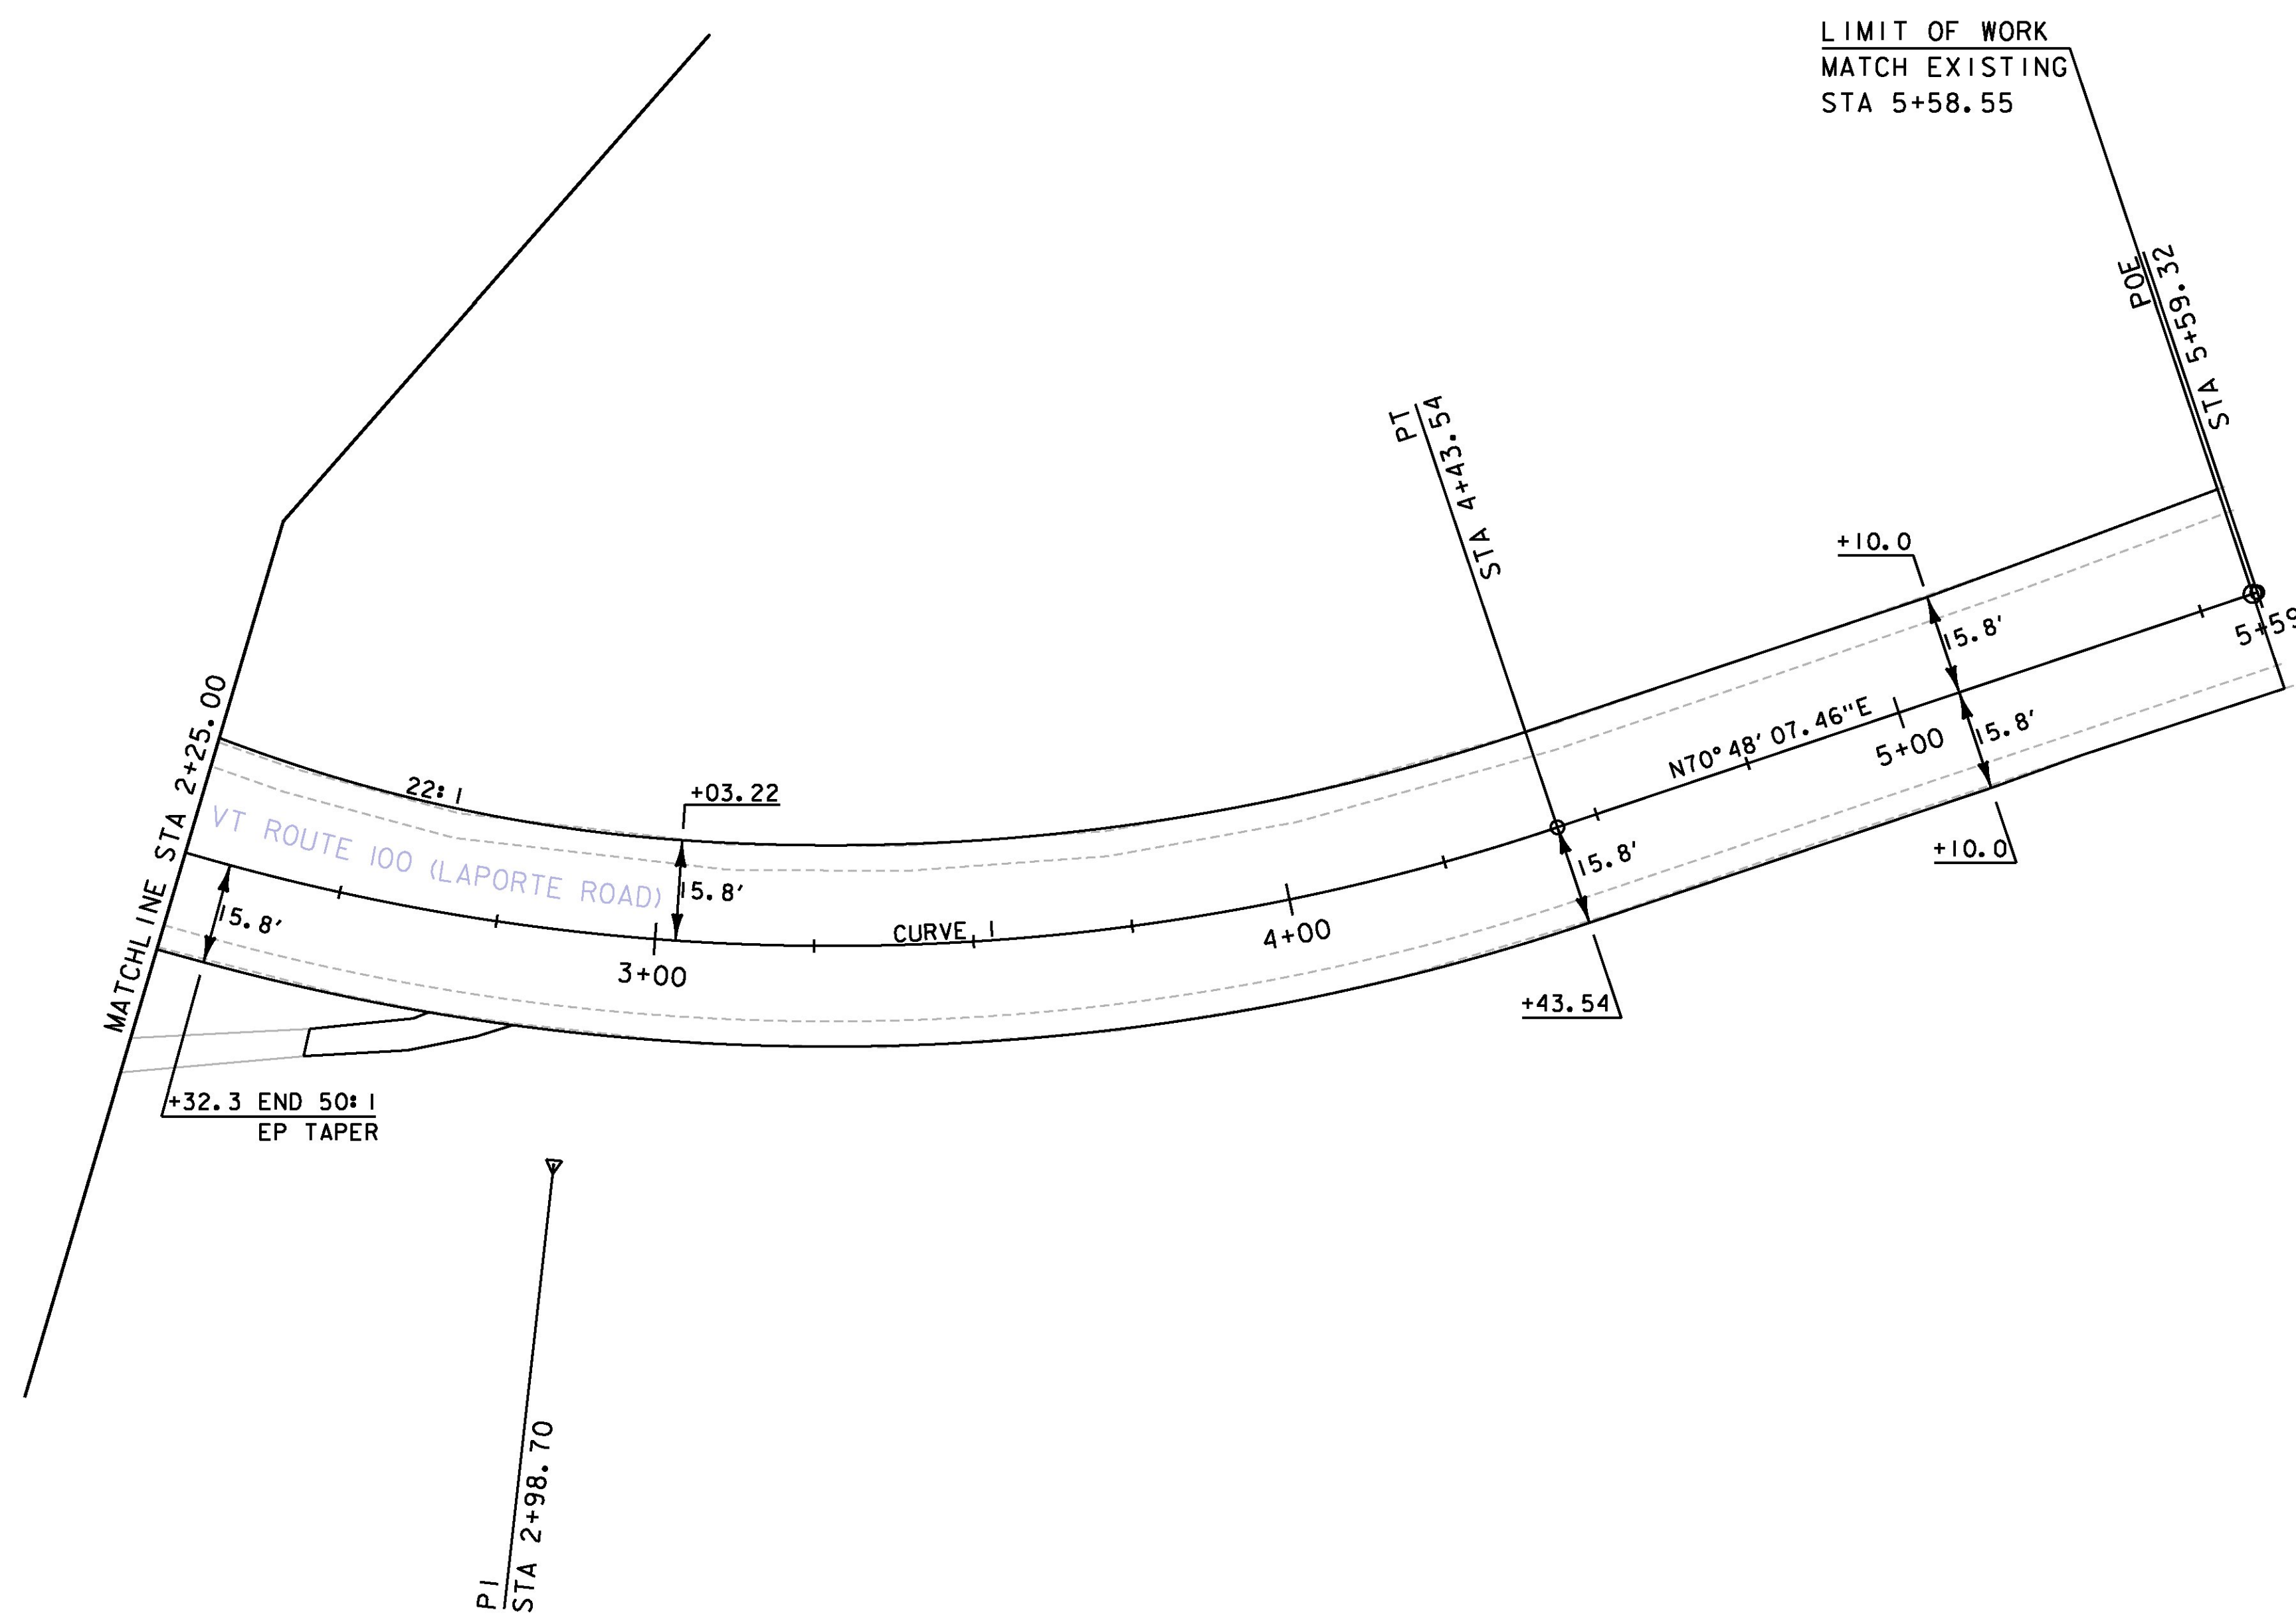

PROJECT NAME:	MORRISTOWN
PROJECT NUMBER:	STPG SGNL(47)
FILE NAME:	z15+047bdr_nul.dgn
PROJECT LEADER:	J. SANTACRUCE
DESIGNED BY:	R. LUCHINI
PAVEMENT LAYOUT AND ALIGNMENT SHEET 2	SHEET 27 OF 58
PLOT DATE:	5/13/2016
DRAWN BY:	R. LUCHINI
CHECKED BY:	B. COLBURN