
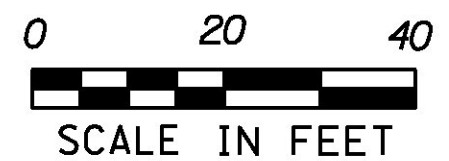


SOIL INFORMATION: SALMON  
 VERY FINE SANDY LOAM  
 15-25% SLOPES  
 K=0.32, HIGHLY ERODIBLE  
 HYDROLOGIC SOIL GROUP: B

SOIL INFORMATION: ADAMS  
 LOAMY FINE SAND  
 8-15% SLOPES  
 K=0.20, ERODIBLE  
 HYDROLOGIC SOIL GROUP: A

SOIL INFORMATION: ADAMS  
 LOAMY FINE SAND  
 15-25% SLOPES  
 K=0.20, ERODIBLE  
 HYDROLOGIC SOIL GROUP: A

PROPOSED CULVERT WORK  
 SEE PEDESTRIAN CULVERT  
 DETAIL SHEET

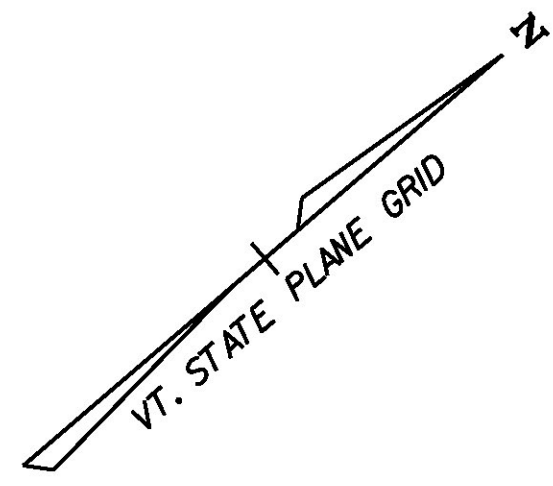

PROJECT NAME:	MORRISTOWN	FILE NAME:	z15+047bdr_ero.dgn	PLOT DATE:	5/13/2016
PROJECT NUMBER:	STPG SGNL(47)	PROJECT LEADER:	J. SANTACRUCE	DRAWN BY:	R. LUCHINI
		DESIGNED BY:	R. LUCHINI	CHECKED BY:	B. COLBURN
		EPSC EXISTING LAYOUT SHEET 1		SHEET	30 OF 58

