

BEGIN PROJECT  
STPG SGNL (47)  
STA 14+50.00

EXISTING R.O.W.

SGR W/STEEL POSTS

AER E&T  
#151/155

AER E&T

AER E&T

AER E&T

UNDERGROUND CABLE BOX

UNDERGROUND TELEPHONE BOX

VT ROUTE 100

VT ROUTE 100  
(LAPORTE ROAD)

ALT VT ROUTE 100

END PROJECT  
STPG SGNL (47)  
STA 20+00.00

LIMIT OF WORK  
MATCH EXISTING  
STA 101+67.50

PI  
STA 100+88.46


PC  
STA 100+23.38

PRC  
STA 101+25.91

PC  
STA 1+32.68

MATCH LINE  
STA 2+25.00

0 20 40  
SCALE IN FEET

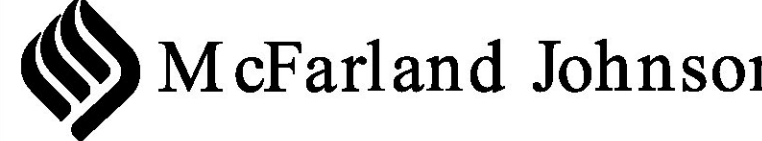

PROJECT NAME: MORRISTOWN	PLOT DATE: 5/13/2016
PROJECT NUMBER: STPG SGNL(47)	DRAWN BY: R. LUCHINI
FILE NAME: z151047bdr_ero.dgn	CHECKED BY: B. COLBURN
PROJECT LEADER: J. SANTACRUCE	SHEET 34 OF 58
DESIGNED BY: R. LUCHINI	
EPSC FINAL LAYOUT SHEET 1	