


I+52.4 SKEWED

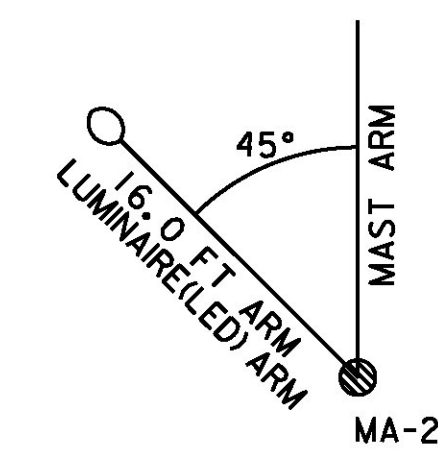

NOTES:

- 1.) VEHICLE STOP BAR DETECTION SYSTEM SHALL BE INSTALLED ON MAST ARM PER MANUFACTURER'S RECOMMENDATIONS AND FIELD VERIFIED BY ENGINEER.

SCALE IN FEET



PROJECT NAME: MORRISTOWN	PLOT DATE: 5/13/2016
PROJECT NUMBER: STPG SGNL(47)	DRAWN BY: R. LUCHINI
FILE NAME: z15+047100alt.dgn	CHECKED BY: B. COLBURN
PROJECT LEADER: J. SANTACRUCE	SHEET 48 OF 58
DESIGNED BY: R. LUCHINI	
MAST ARM CROSS SECTION 2	