




15+50

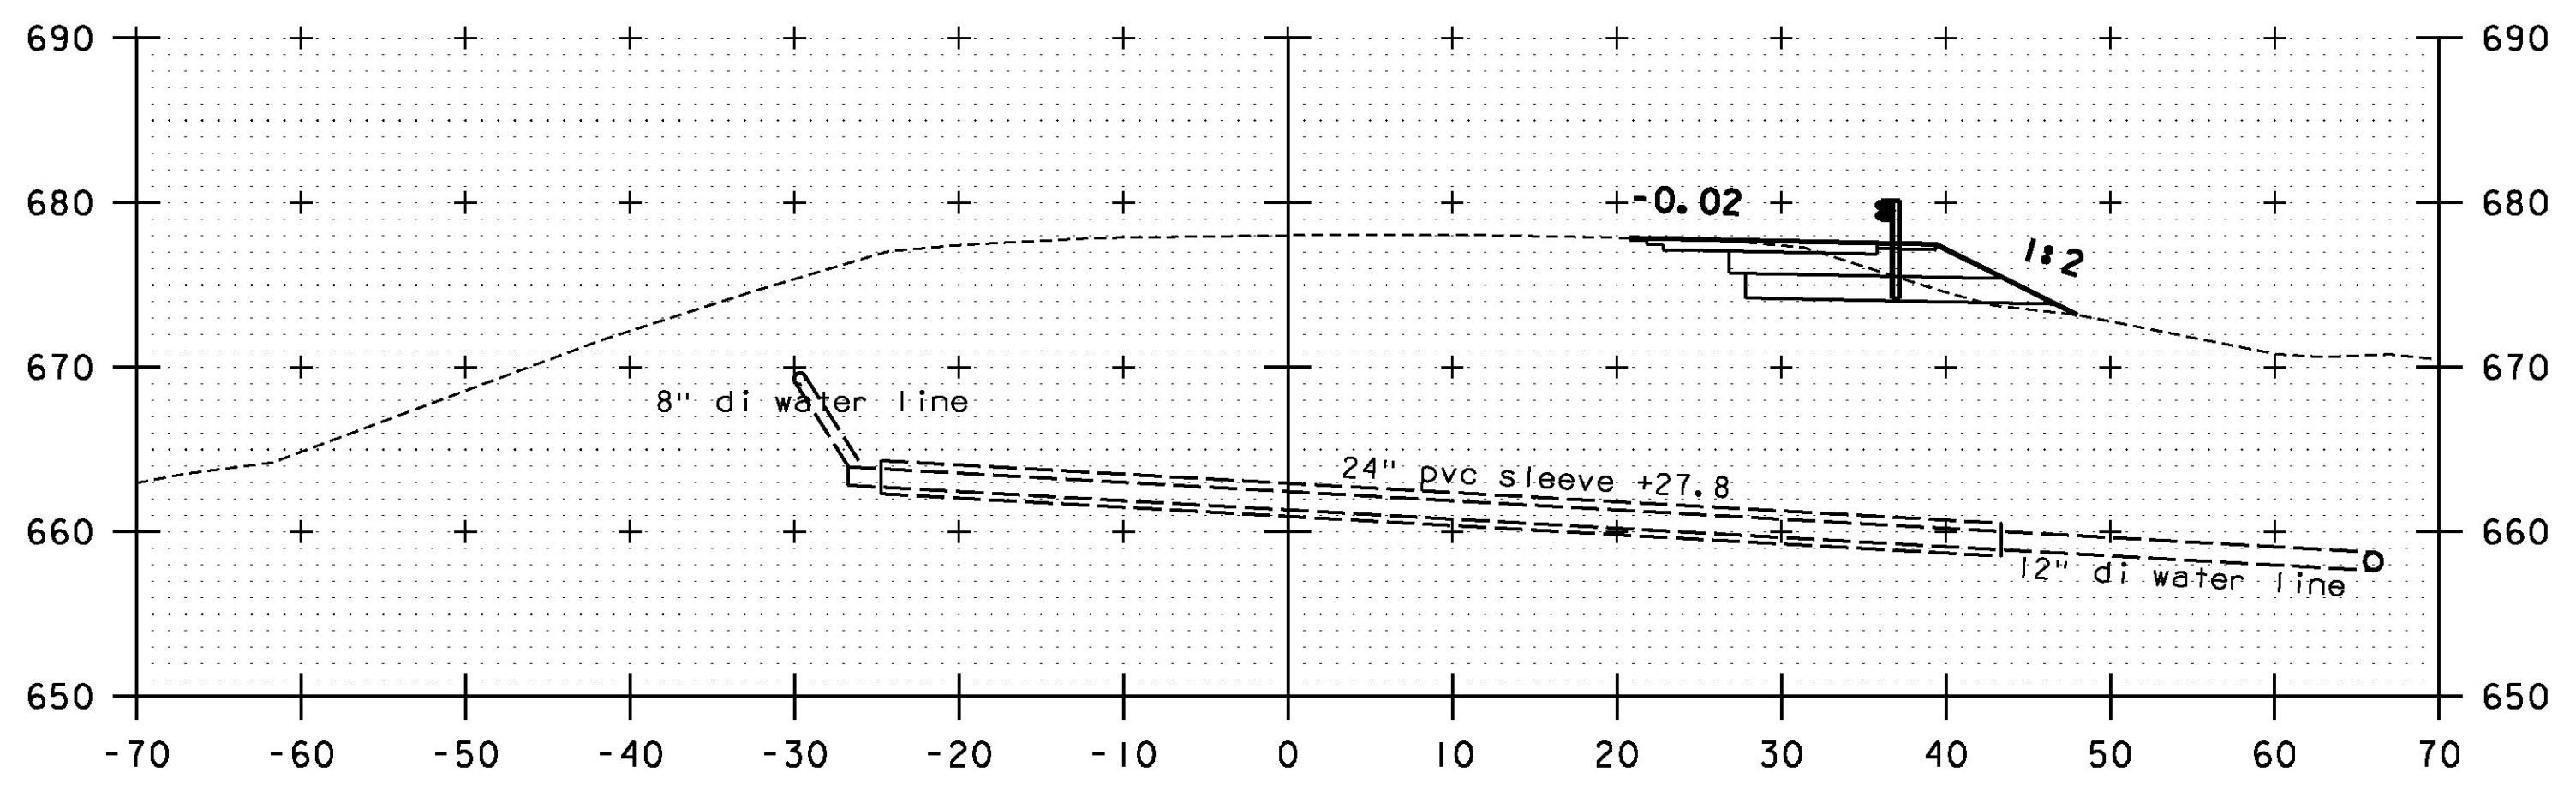


17+00

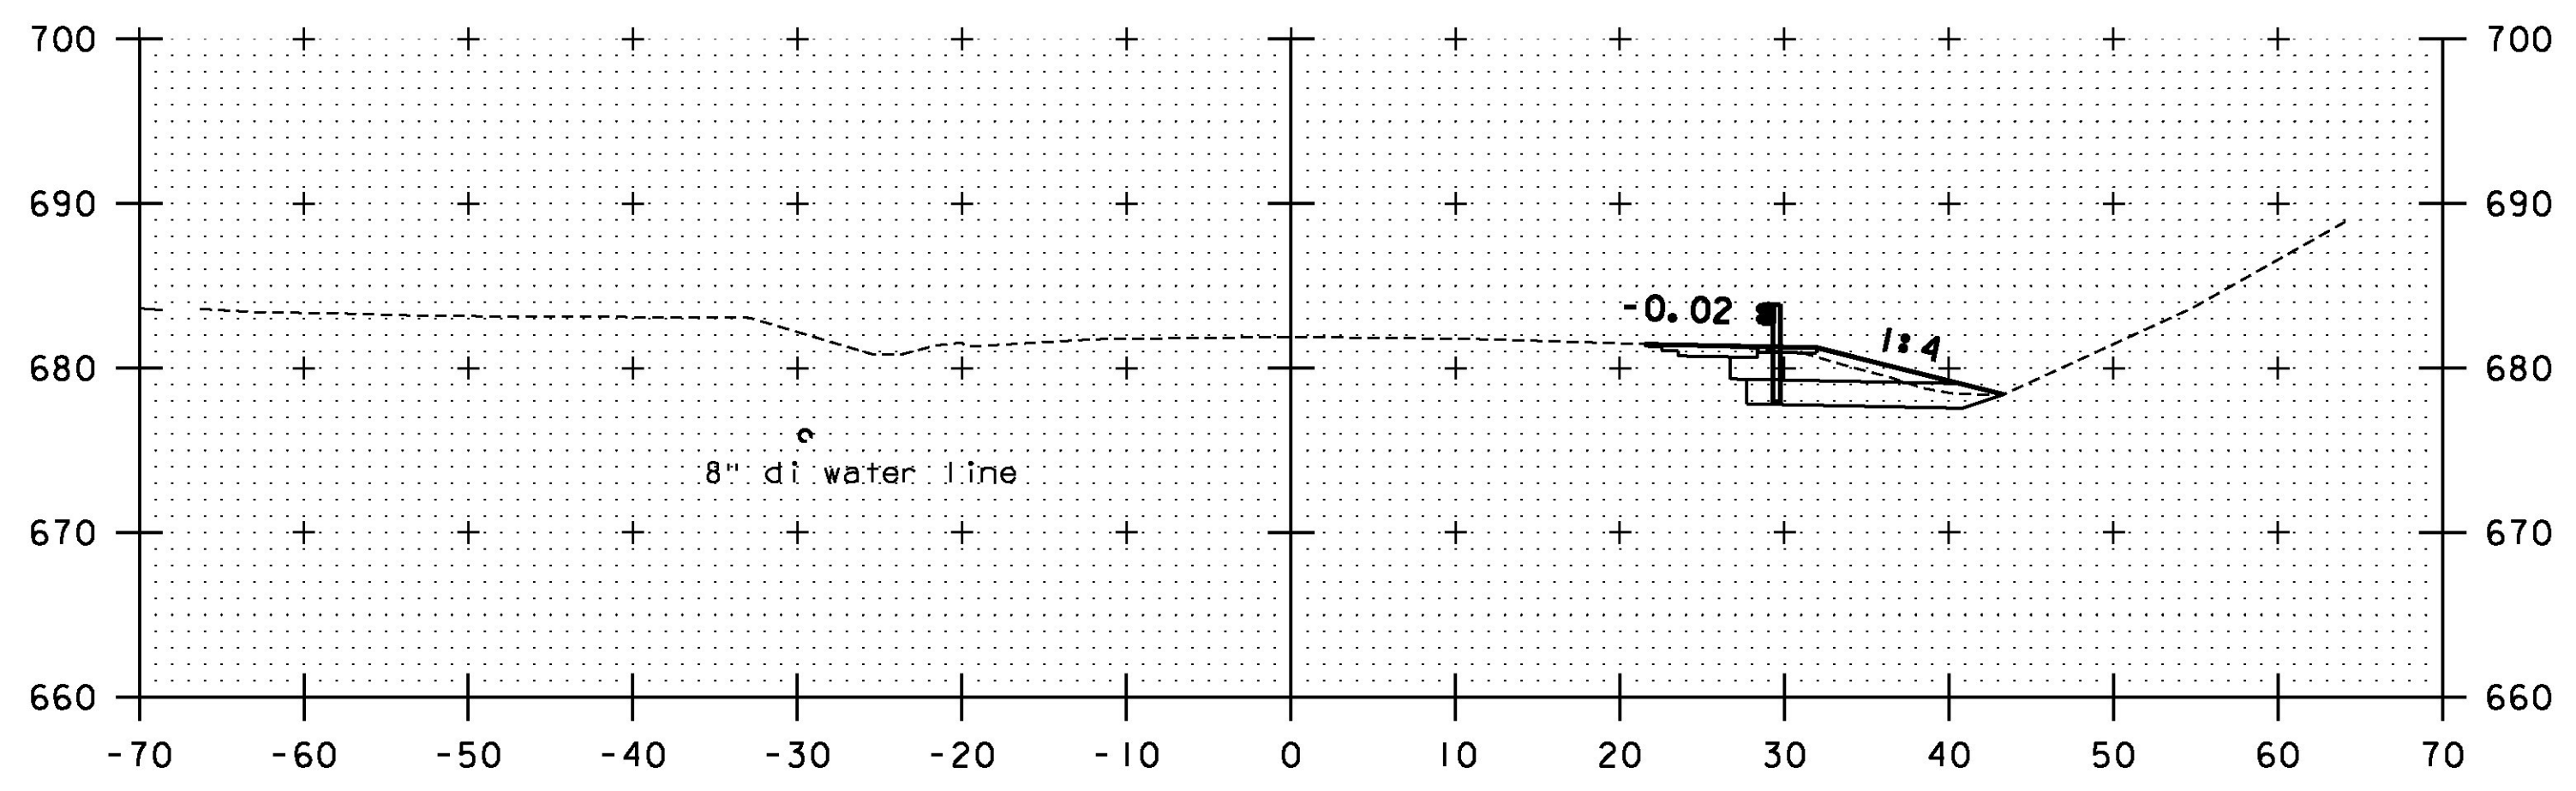


15+00

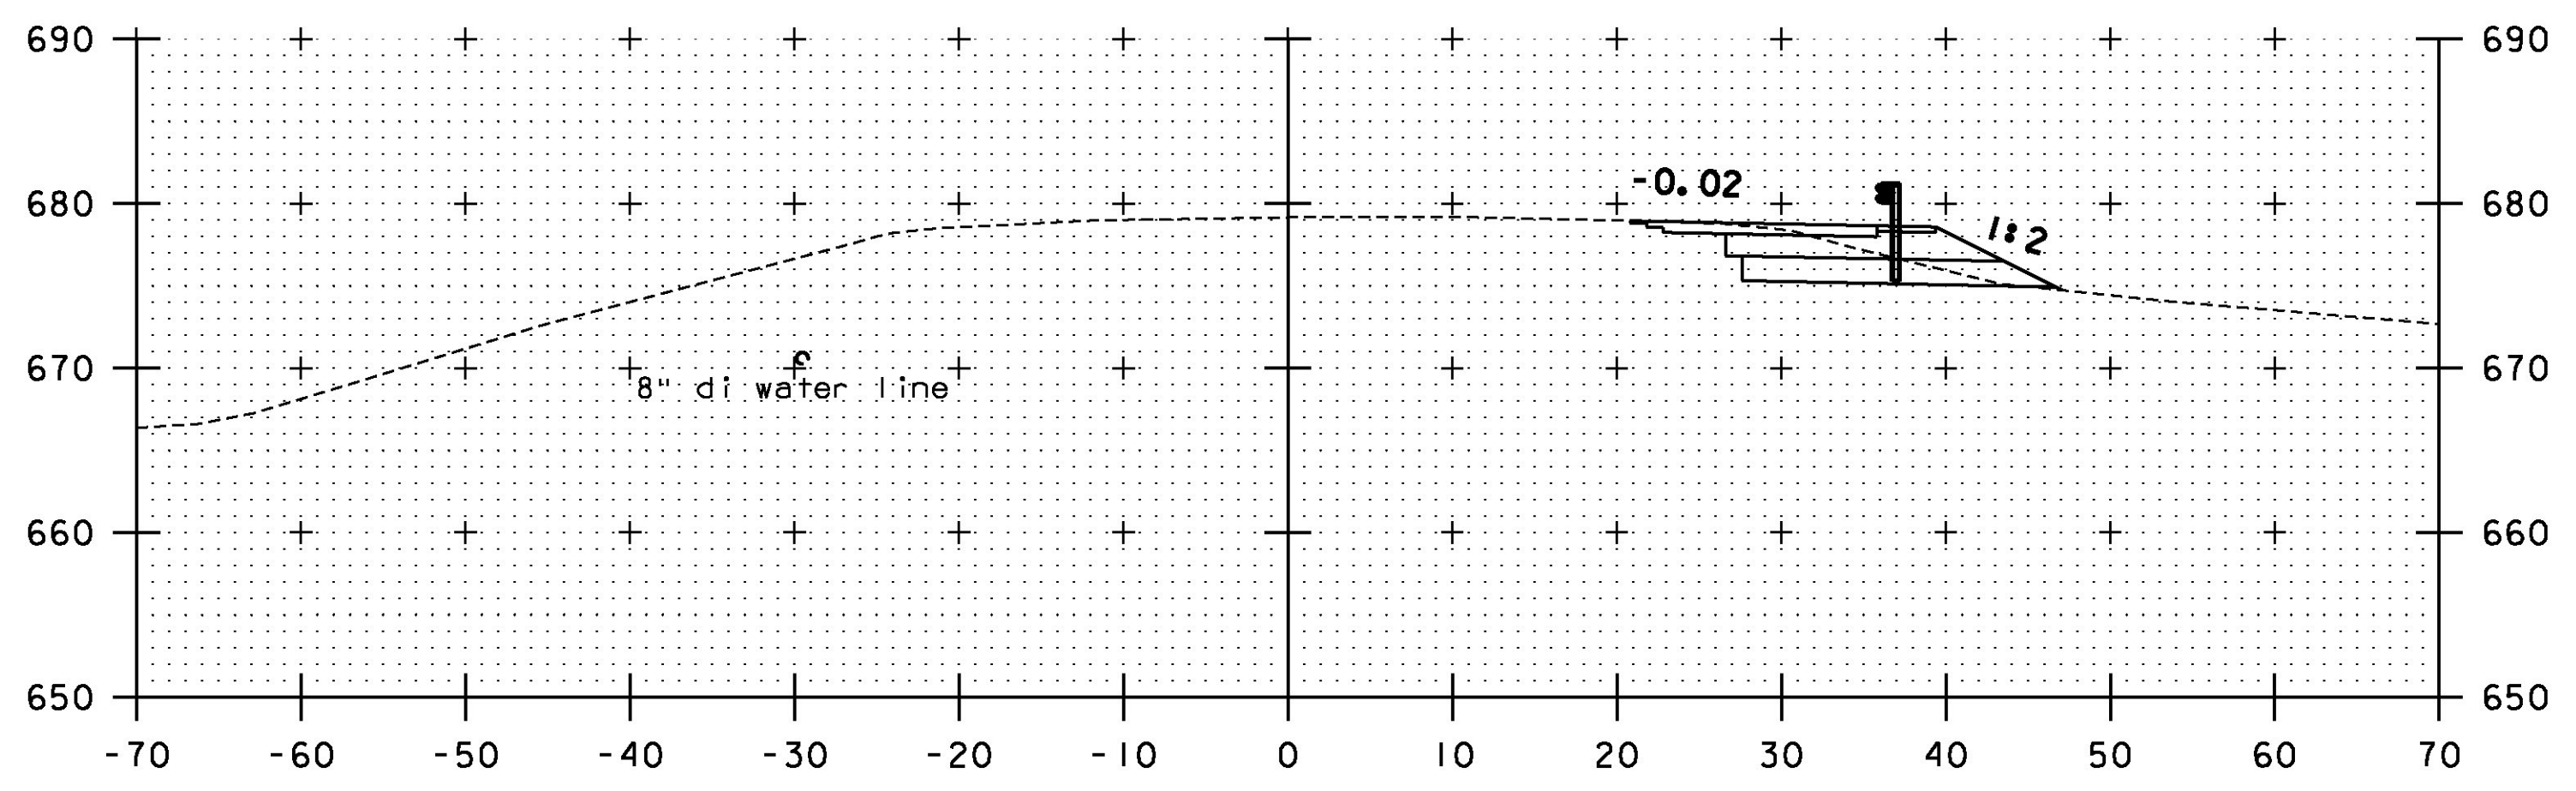

16+50

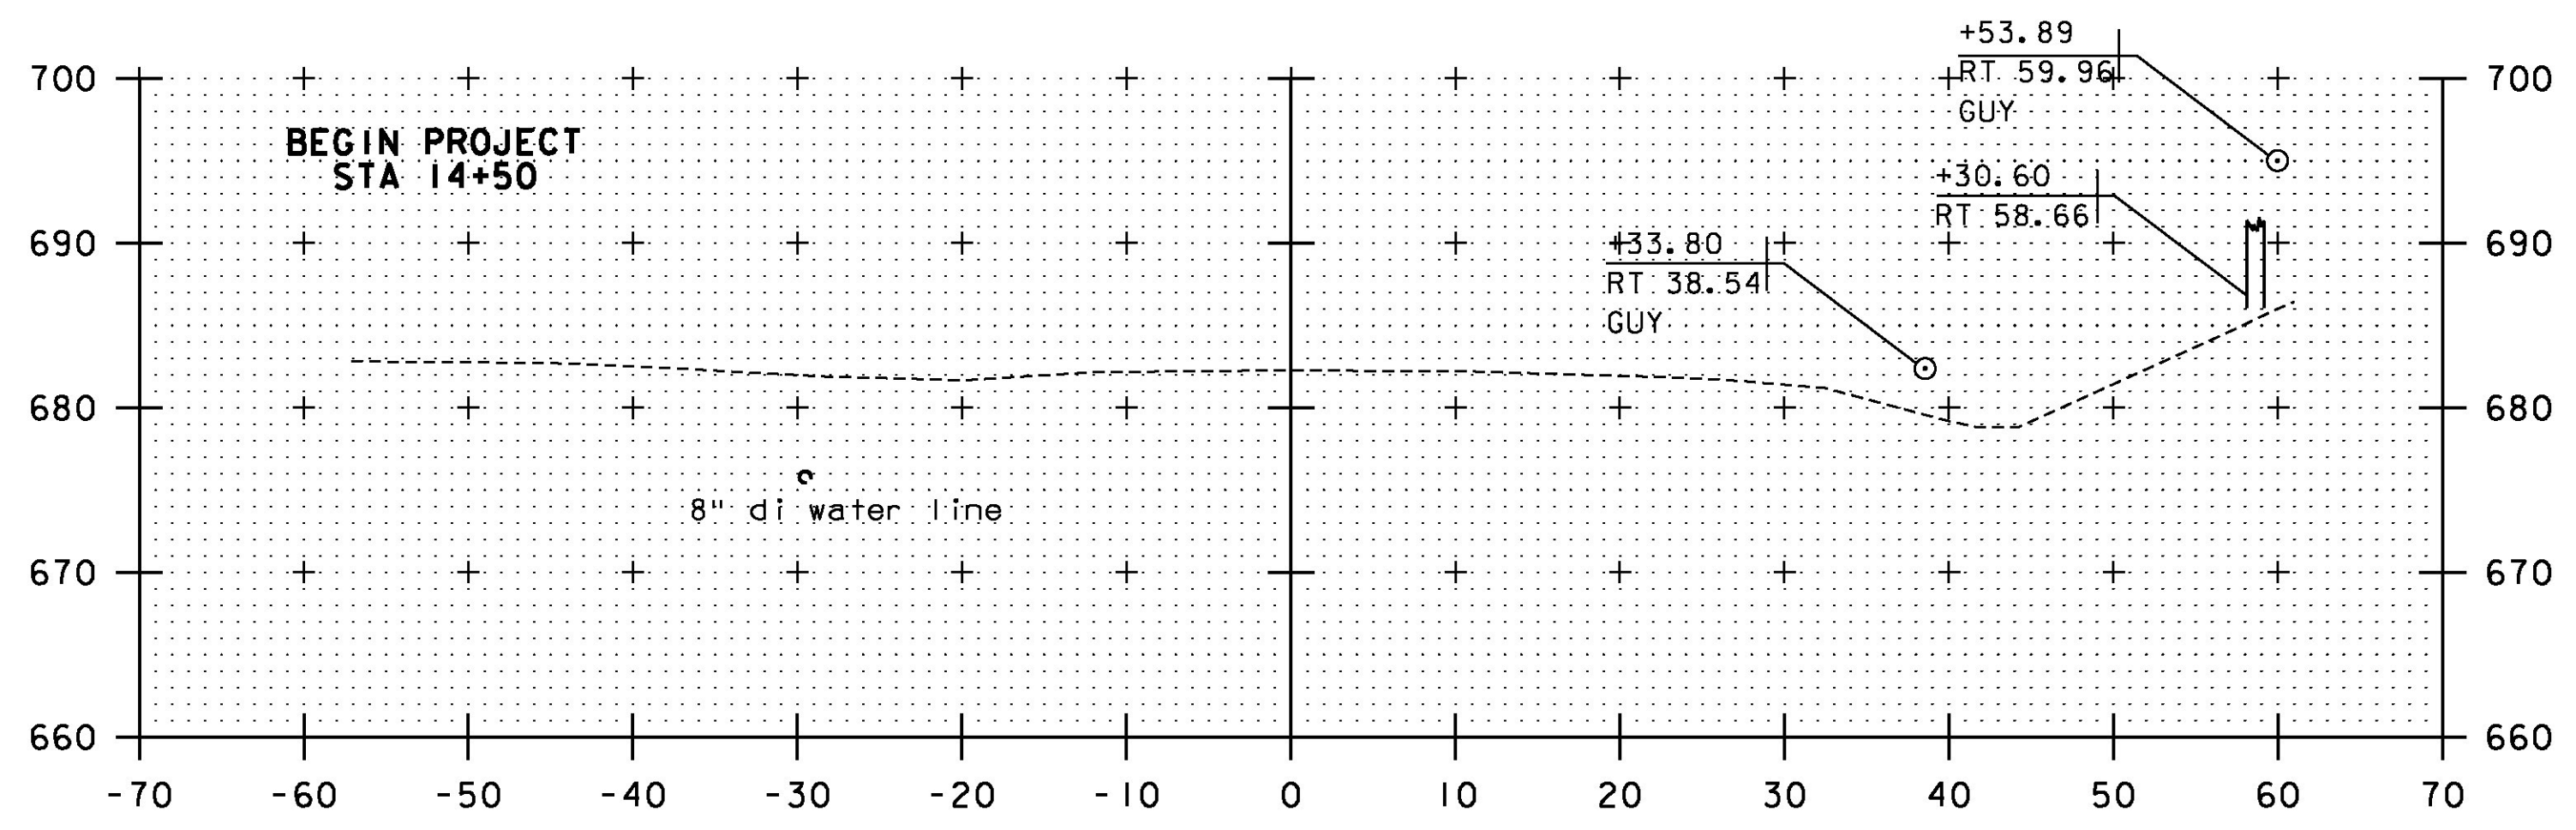

14+50

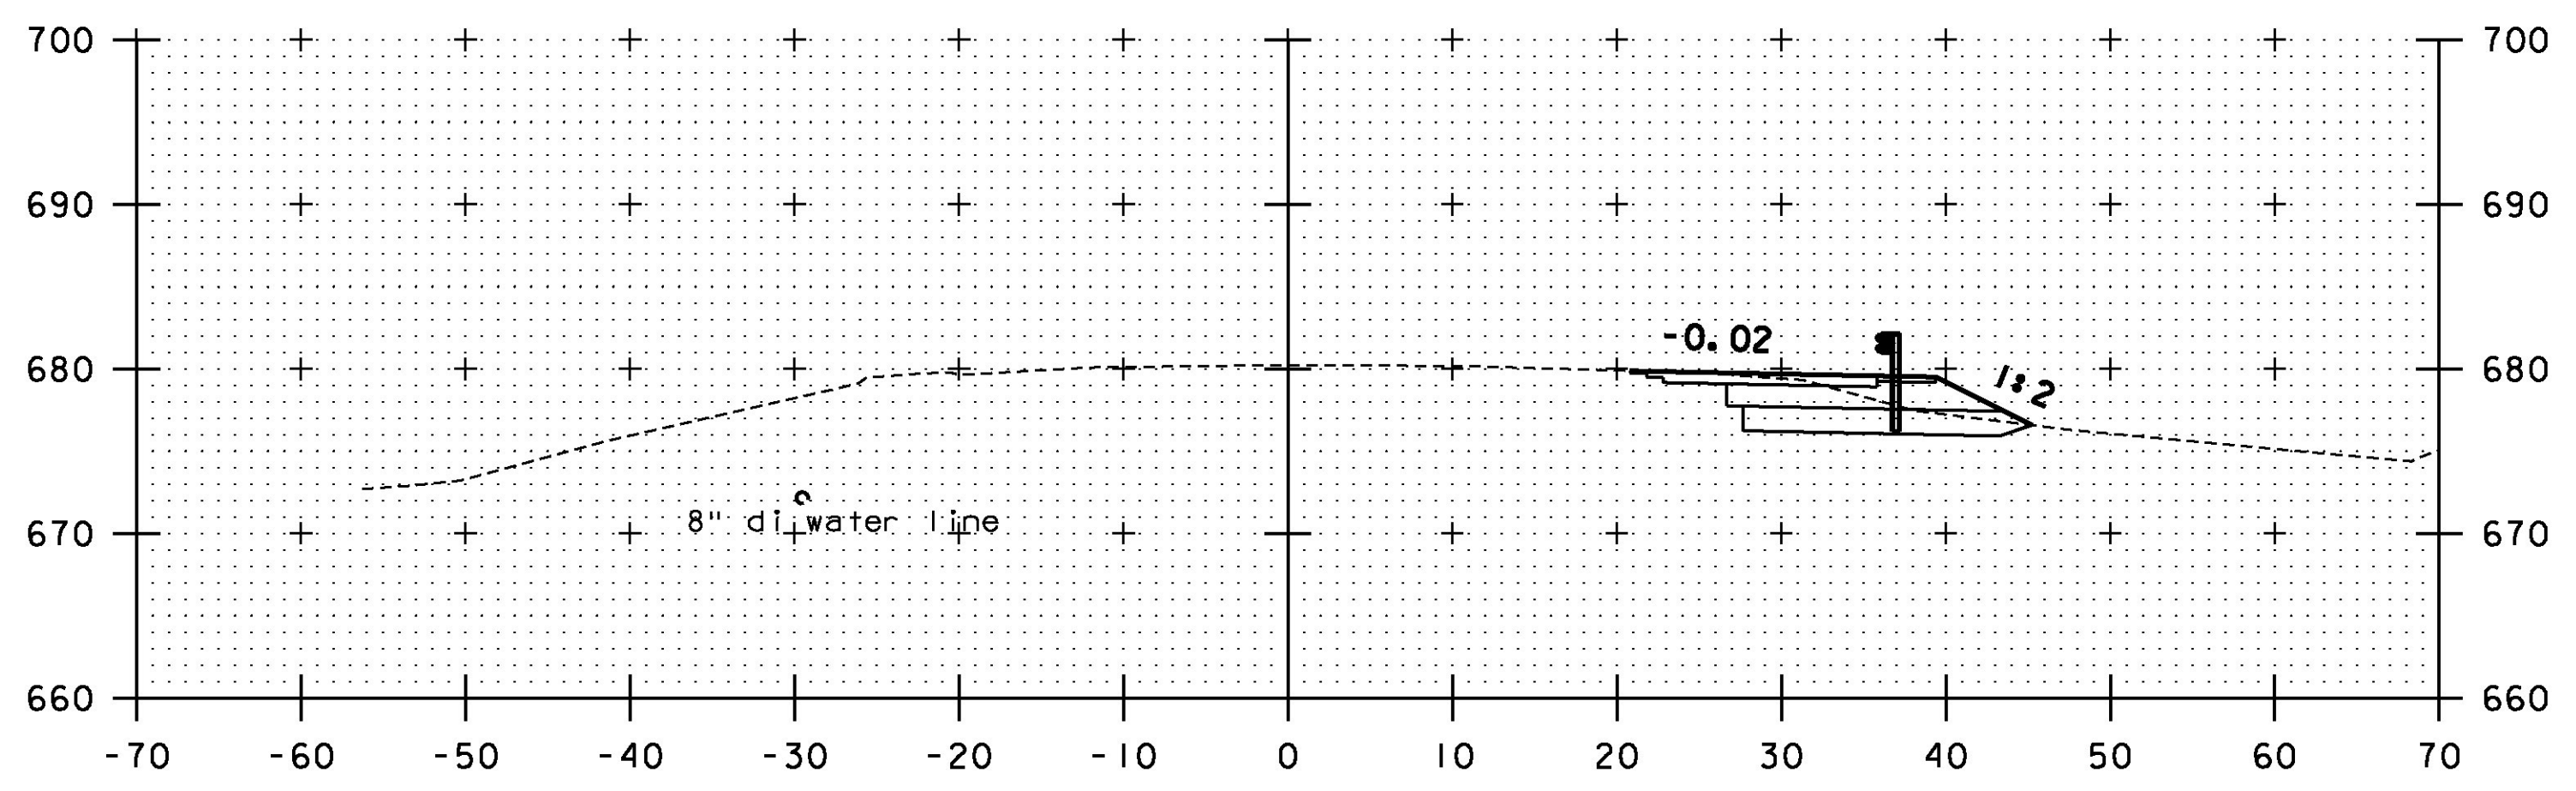

16+00

SCALE IN FEET



PROJECT NAME:	MORRISTOWN	PLOT DATE:	5/13/2016
PROJECT NUMBER:	STPG SGNL(47)	DRAWN BY:	R. LUCHINI
FILE NAME:	z15+047xs_100alt.dgn	CHECKED BY:	B. COLBURN
PROJECT LEADER:	J. SANTACRUCE	CROSS SECTION -	VT 100
DESIGNED BY:	R. LUCHINI		SHEET 51 OF 58