




18+50

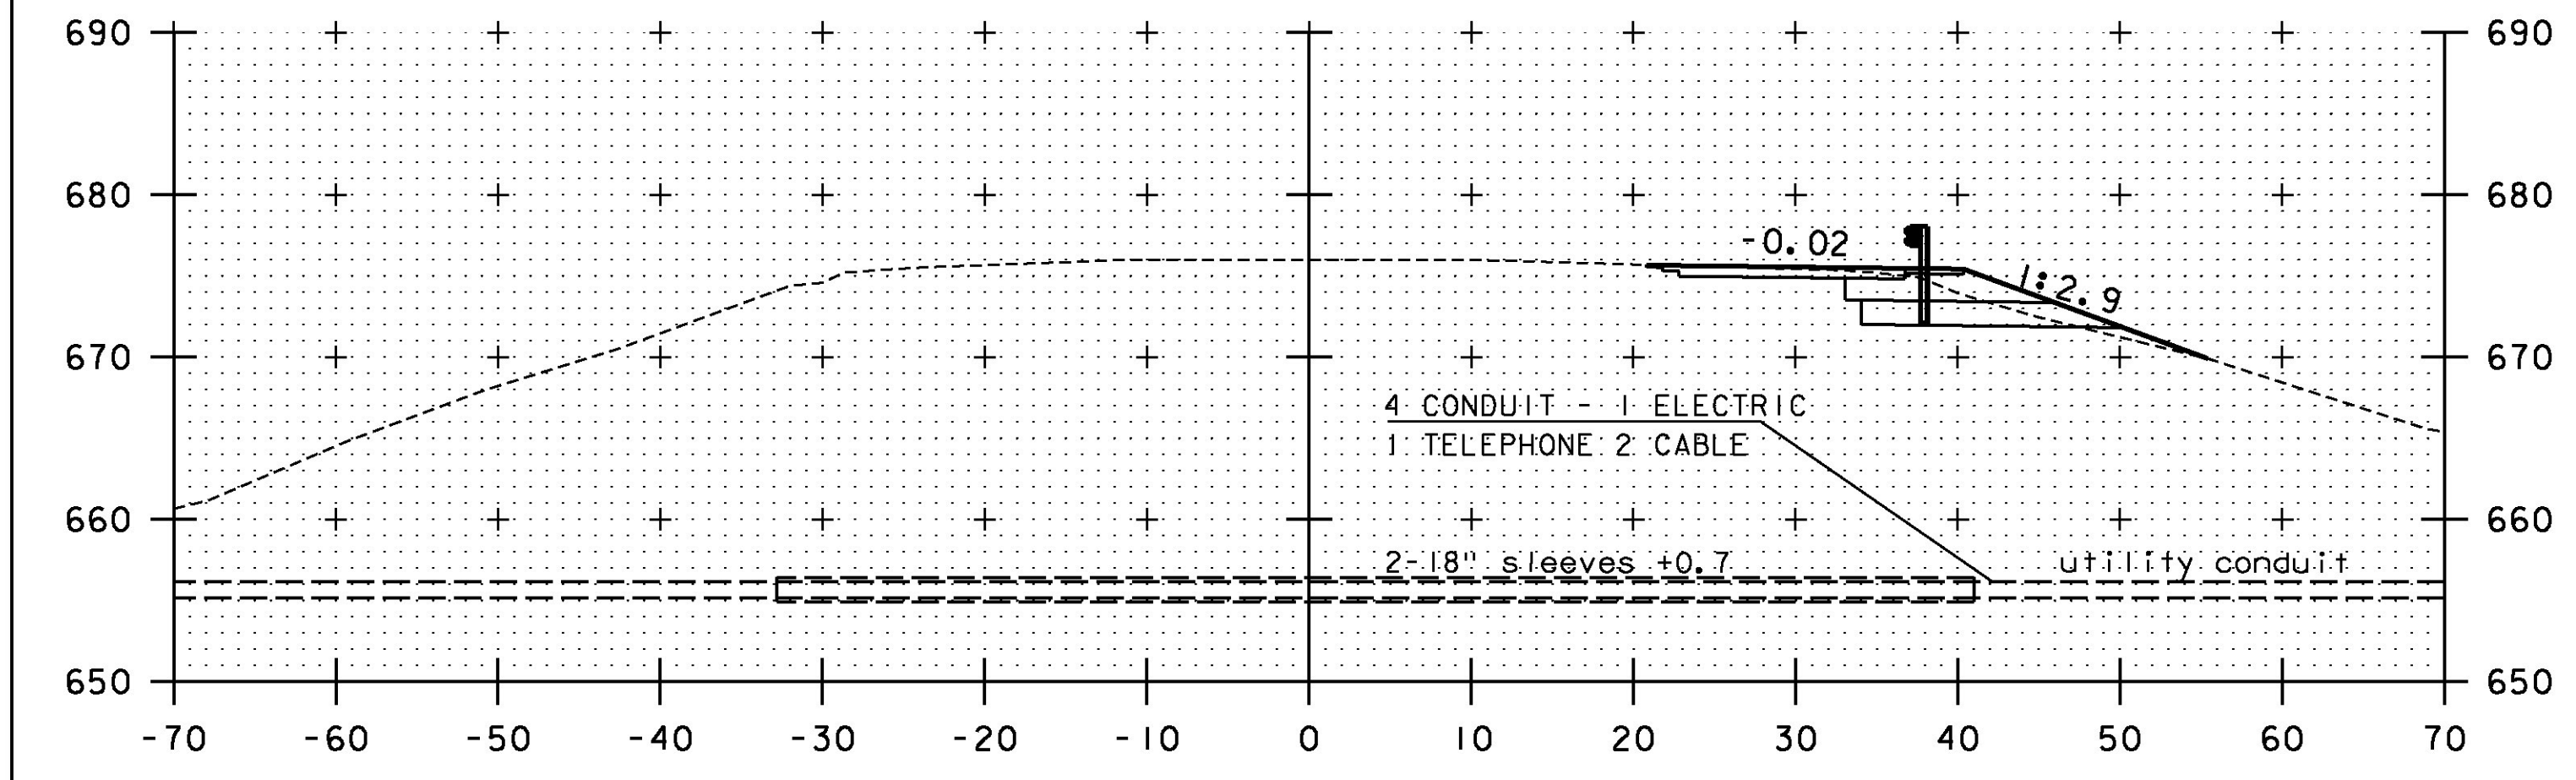


18+00

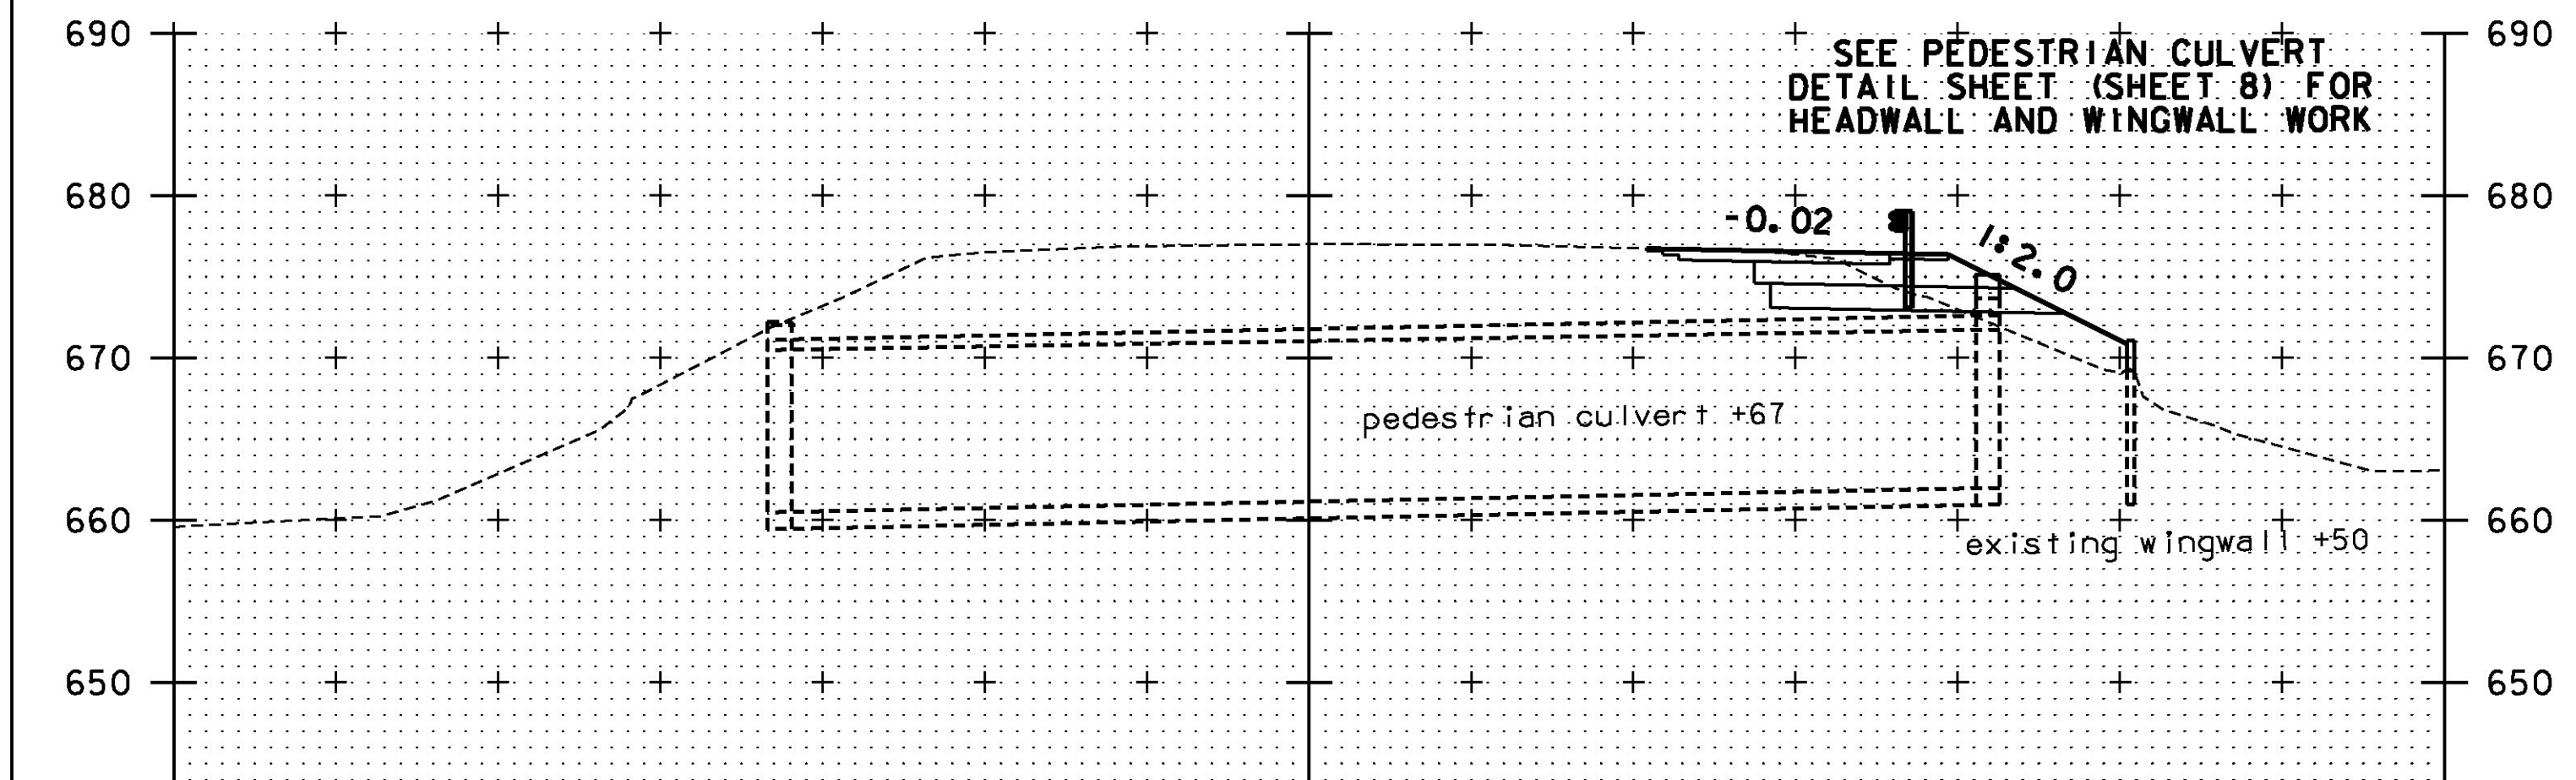


17+50

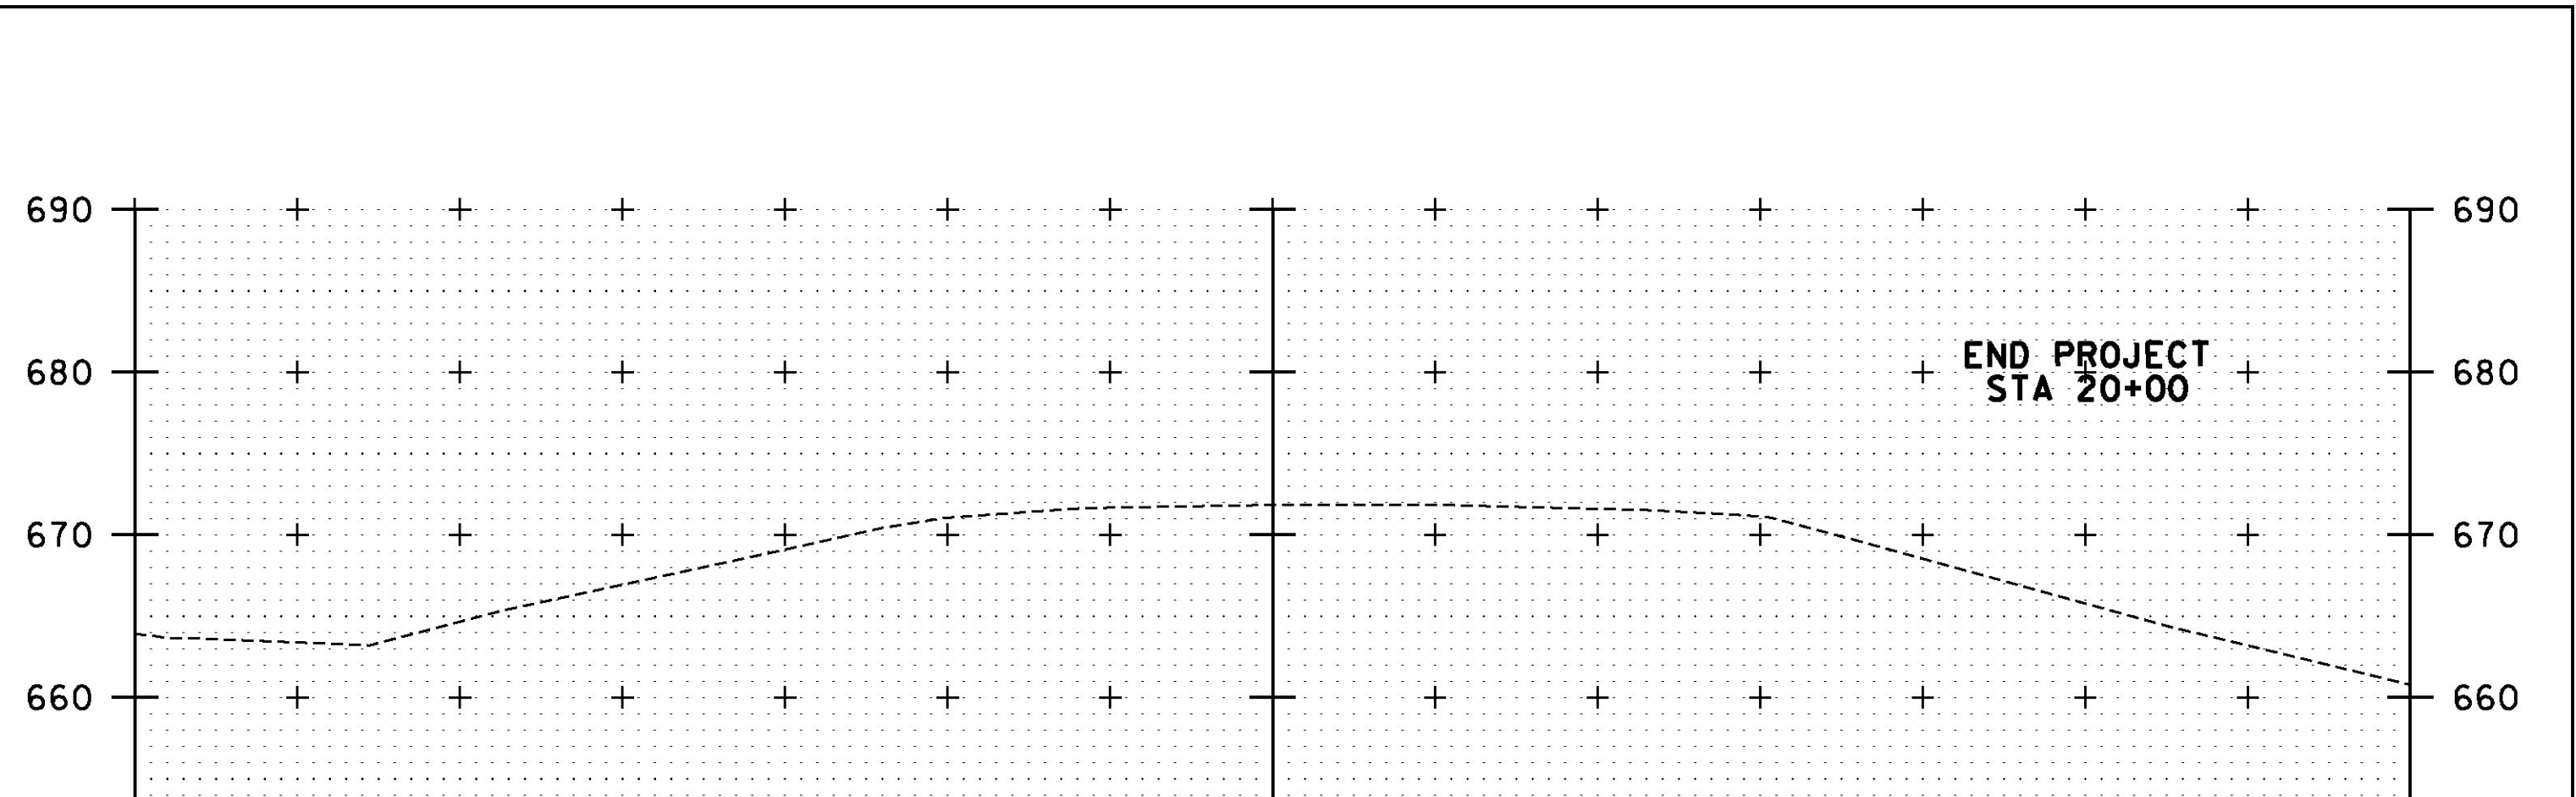

20+00

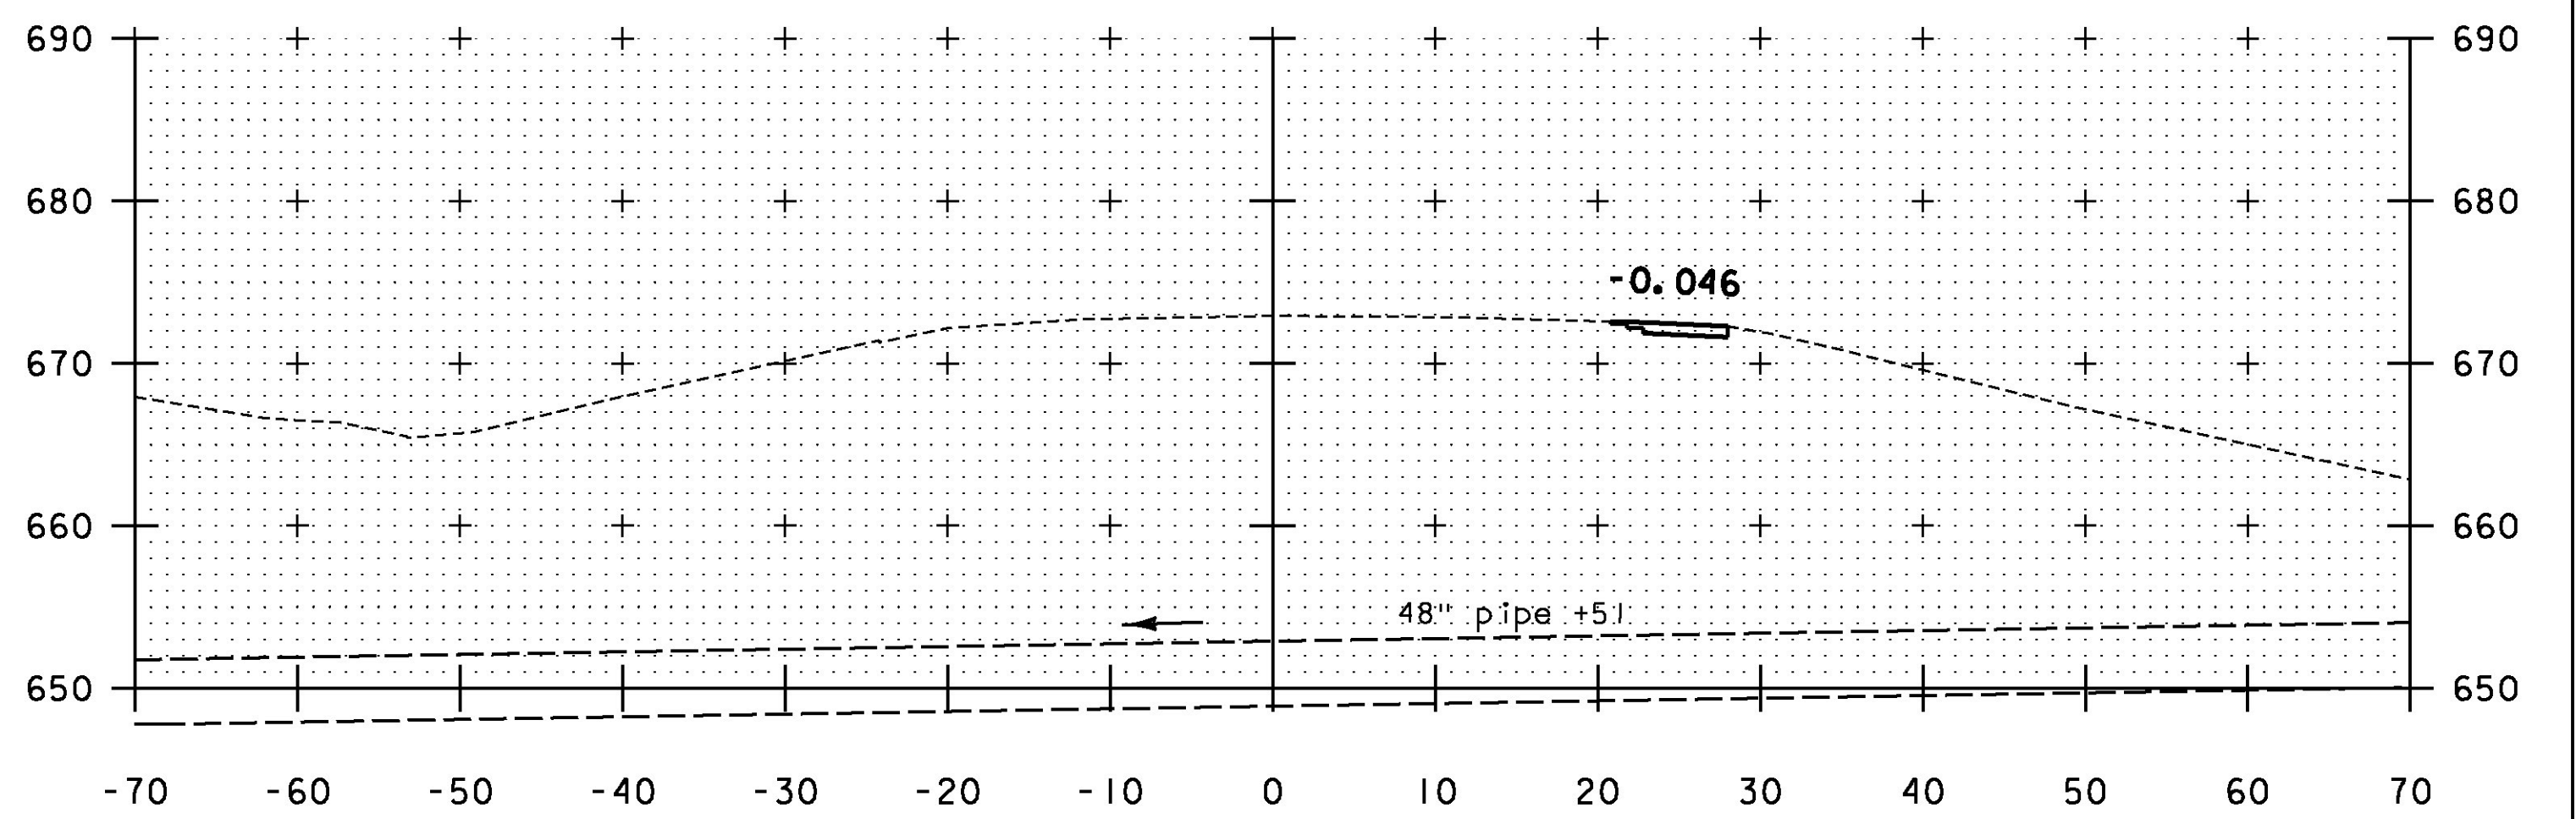

19+50

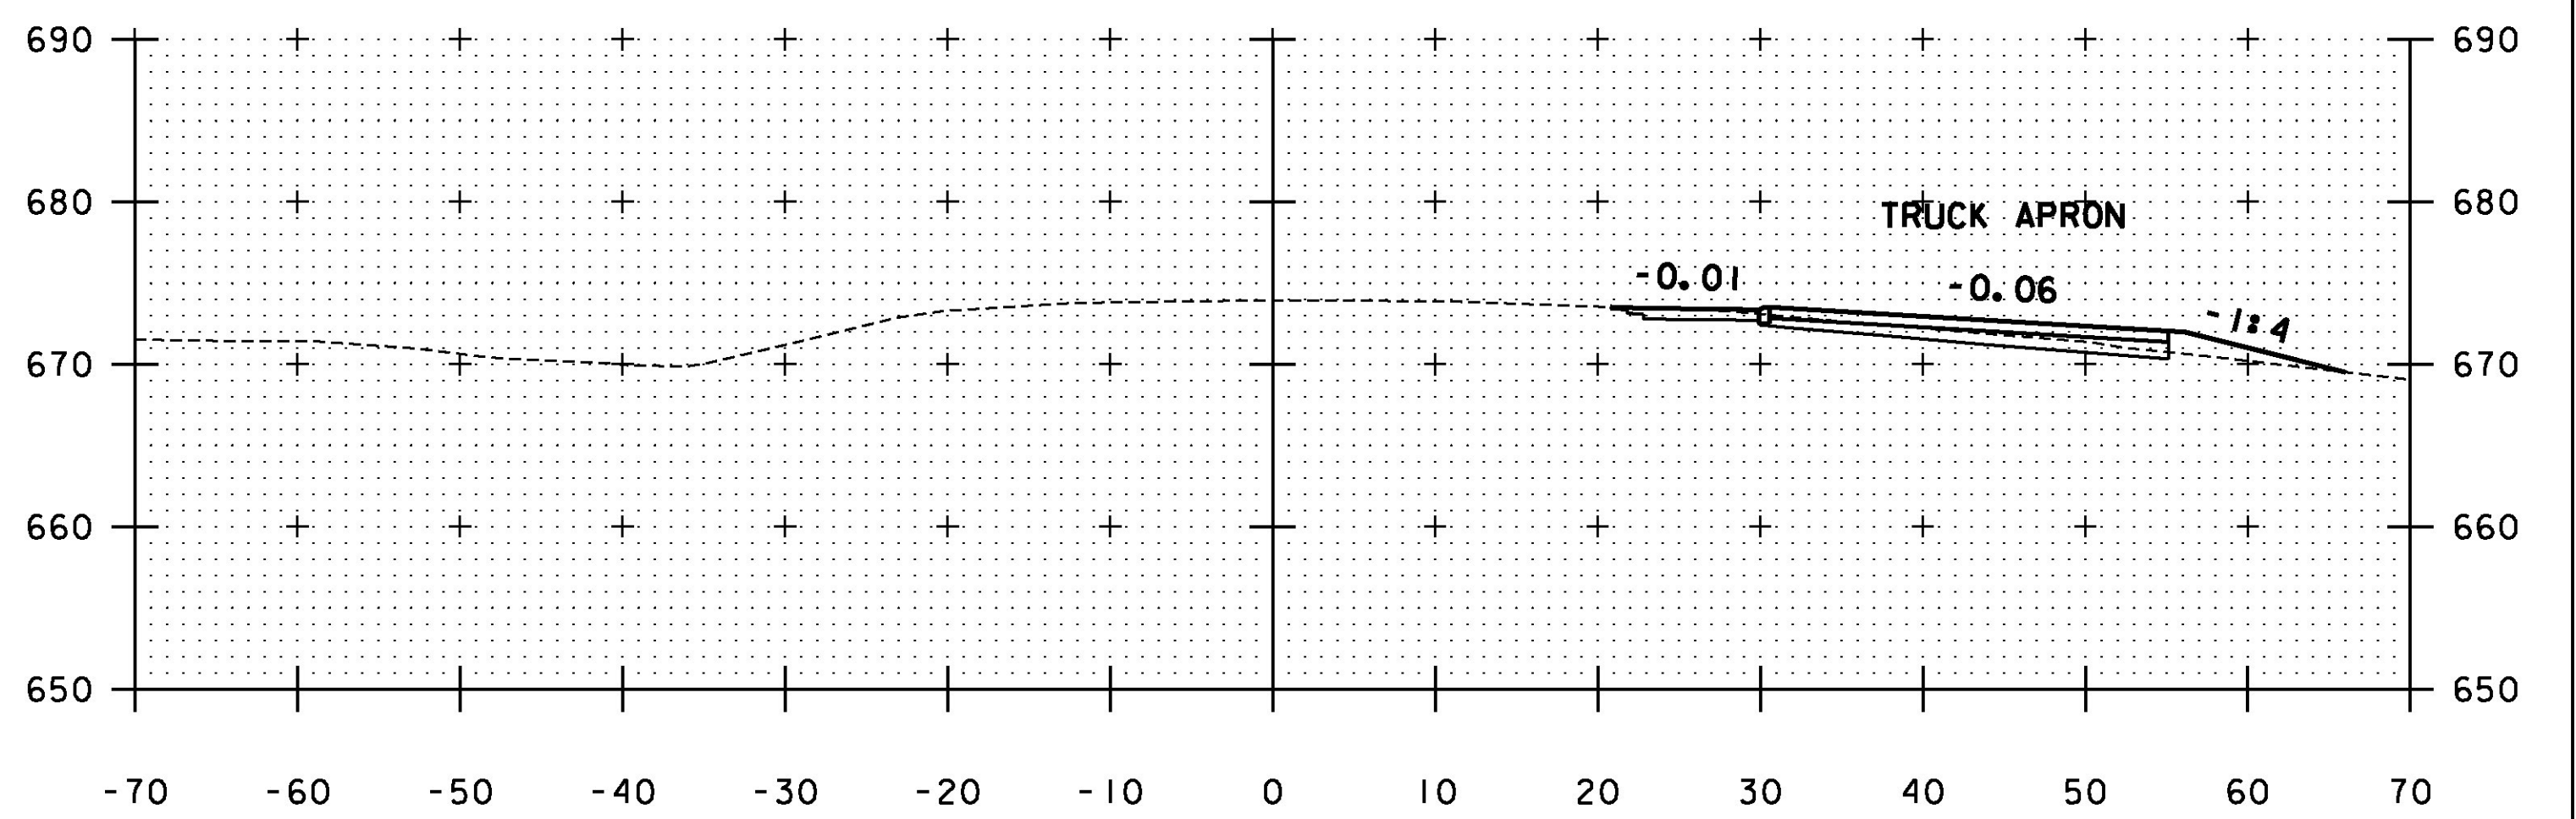

19+00

SCALE IN FEET



PROJECT NAME:	MORRISTOWN	FILE NAME:	z15+047xs_100al+dgn	PLOT DATE:	5/13/2016
PROJECT NUMBER:	STPG SGNL(47)	PROJECT LEADER:	J. SANTACRUCE	DRAWN BY:	R. LUCHINI
		DESIGNED BY:	R. LUCHINI	CHECKED BY:	B. COLBURN
		CROSS SECTION -	VT 100	SHEET	52 OF 58