




5+50

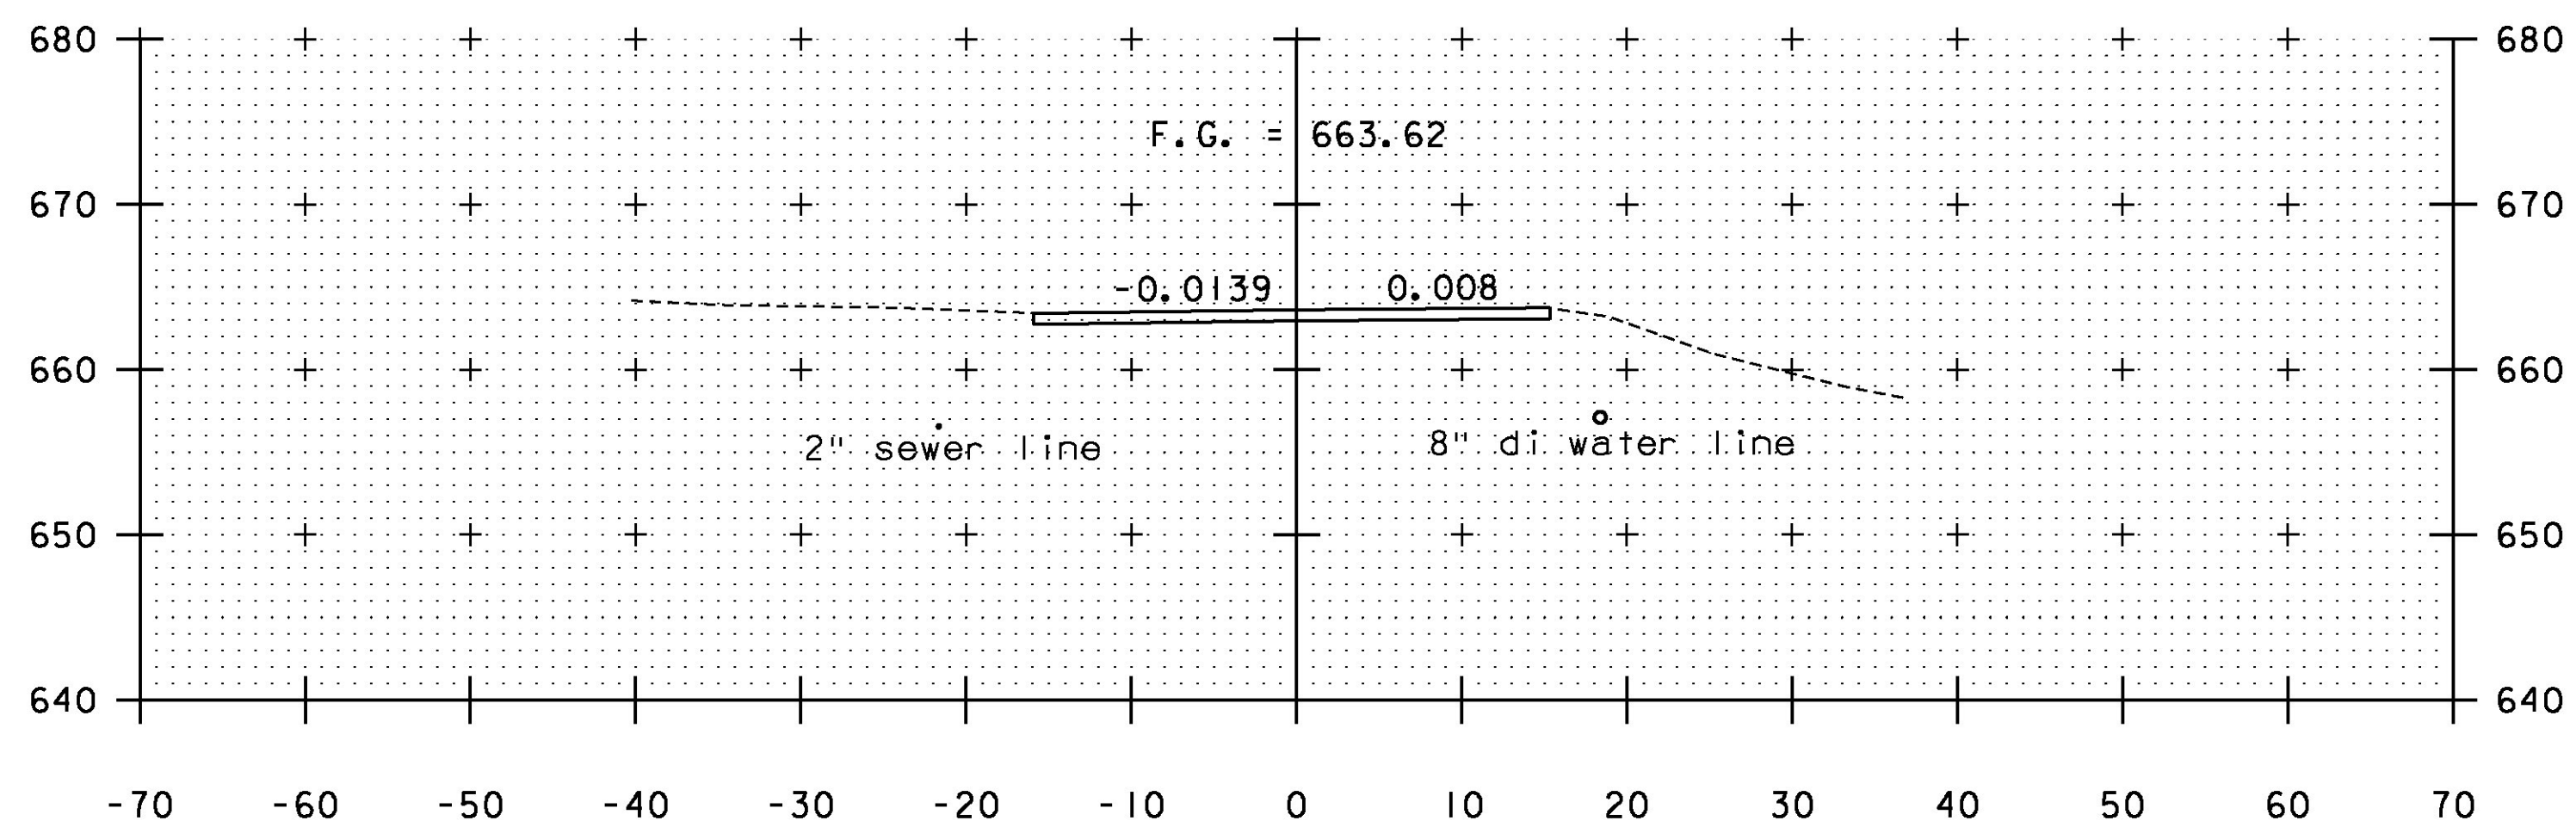

5+00

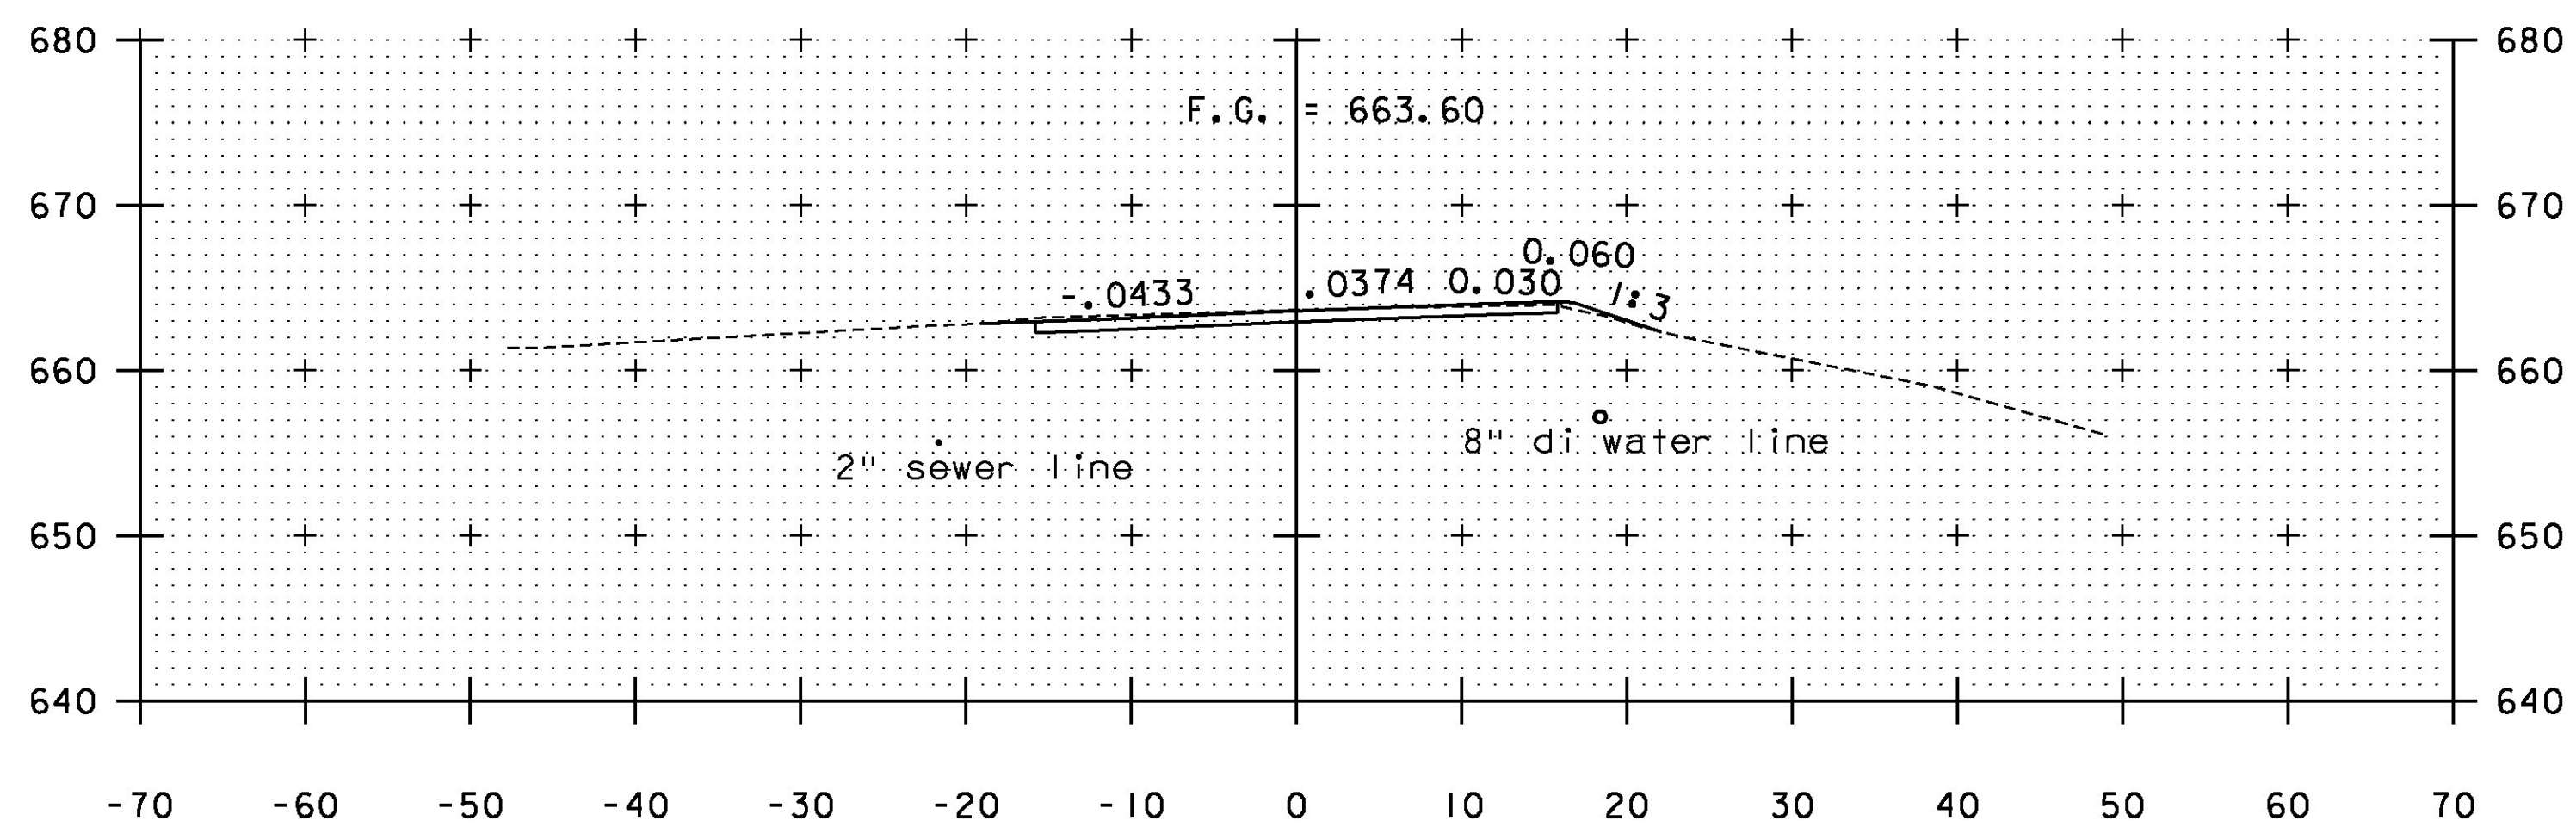

4+50

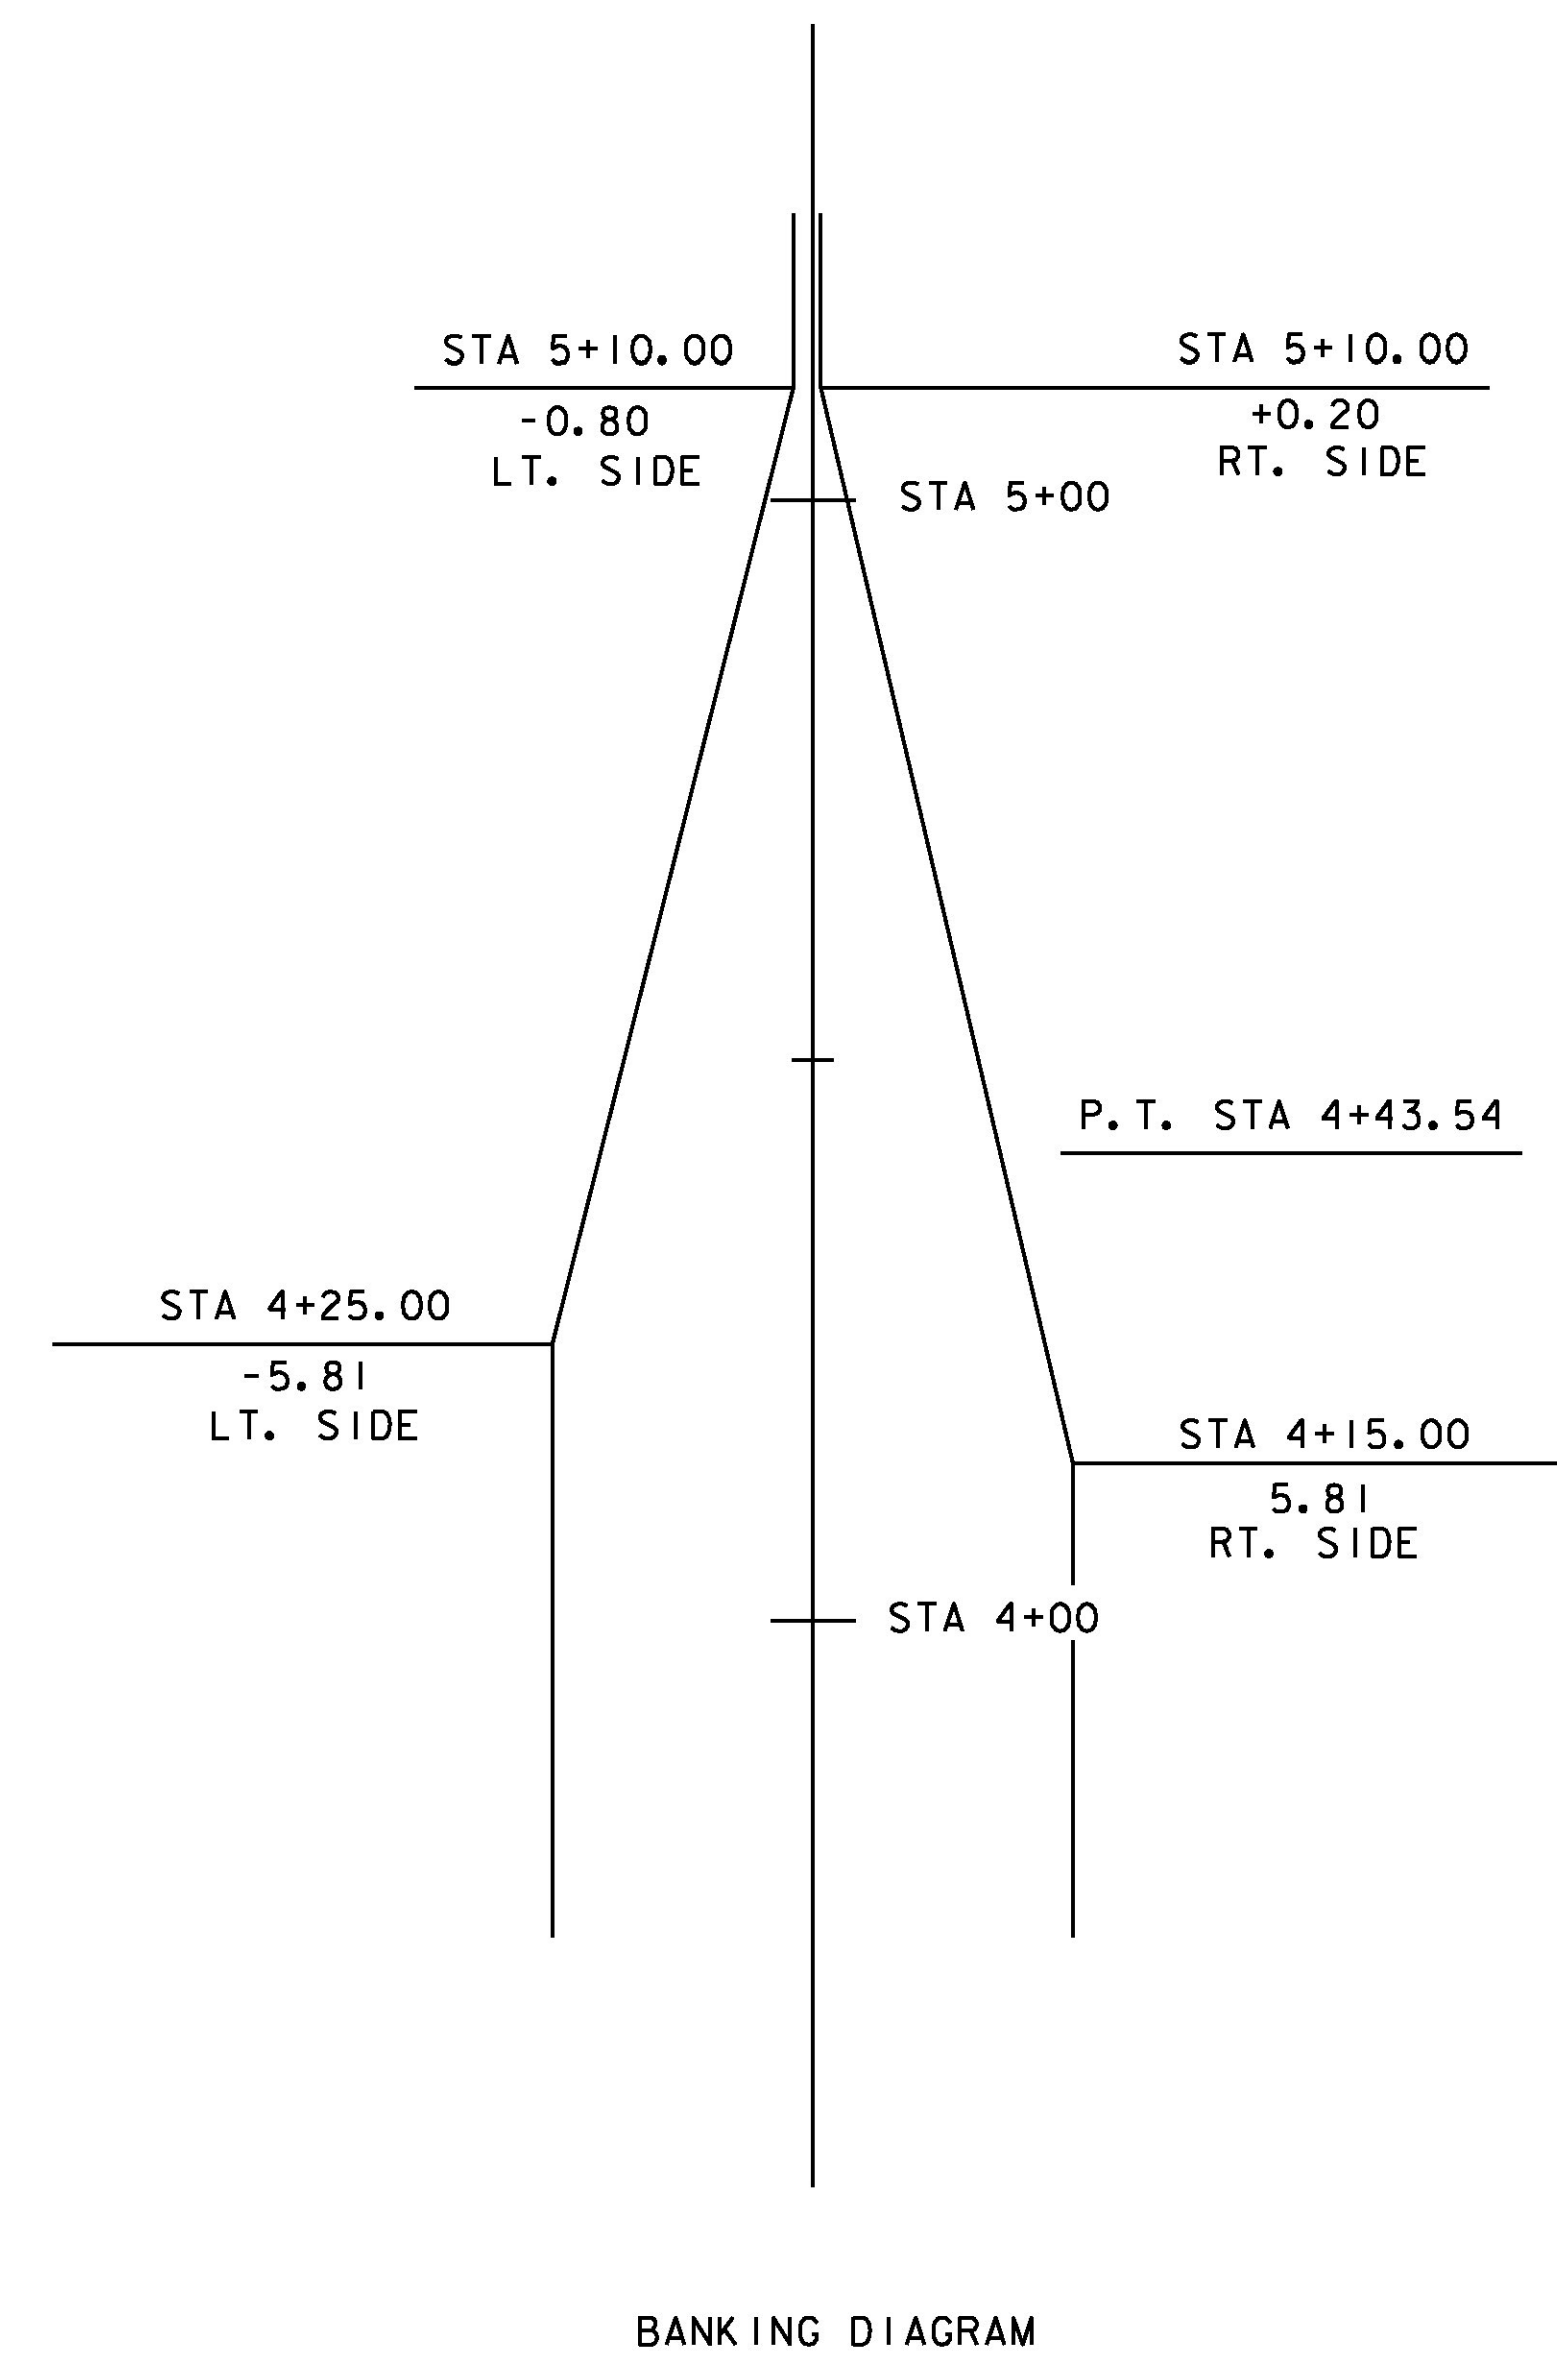

SCALE IN FEET



PROJECT NAME:	MORRISTOWN	PLOT DATE:	5/13/2016
PROJECT NUMBER:	STPG SGNL(47)	DRAWN BY:	R. LUCHINI
FILE NAME:	z15+047xs_100alt.dgn	DESIGNED BY:	R. LUCHINI
CROSS SECTION - VT 100 (LAPORTE ROAD)		CHECKED BY:	B. COLBURN
		SHEET	54 OF 58