


LEGEND

▨ PHASE II WORK LIMITS



PROJECT NAME: MORRISTOWN	PLOT DATE: 5/13/2016
PROJECT NUMBER: STPG SGNL(47)	DRAWN BY: R. LUCHINI
FILE NAME: z15+047bdr_dtr.dgn	CHECKED BY: B. COLBURN
PROJECT LEADER: J. SANTACRUCE	SHEET 57 OF 58
DESIGNED BY: R. LUCHINI	
TRAFFIC CONTROL LAYOUT SHEET 2	

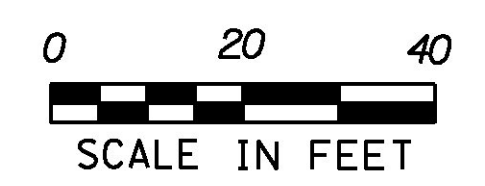