

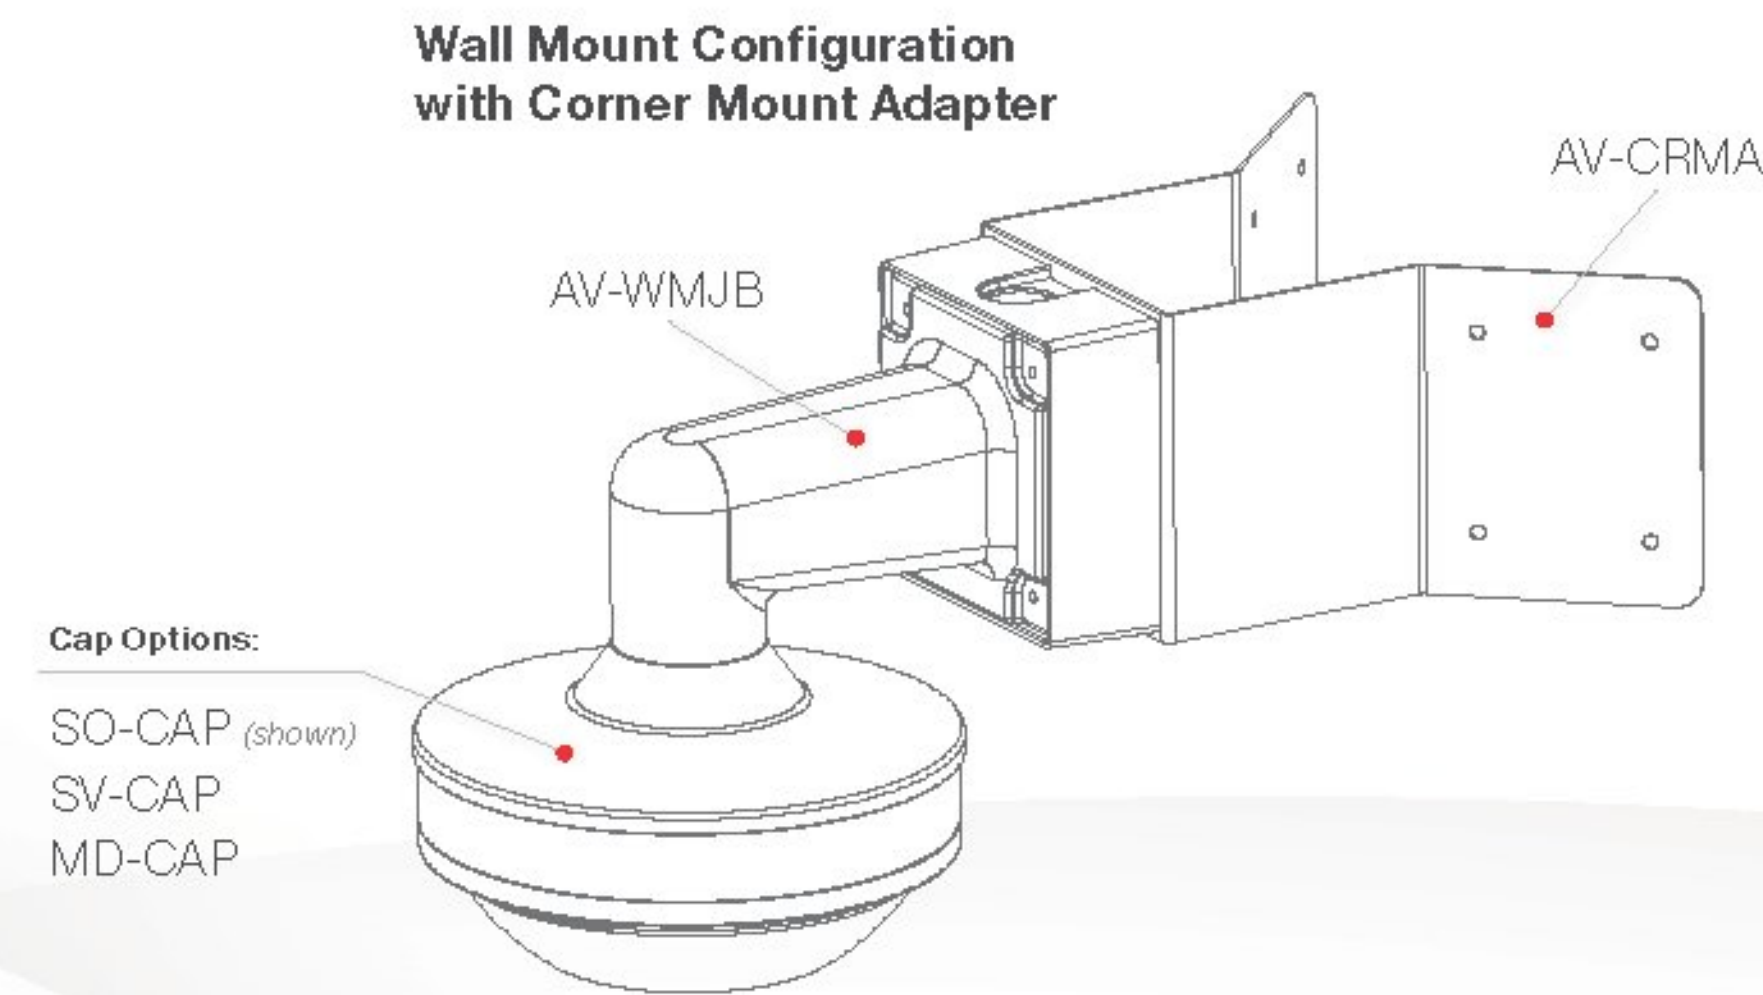
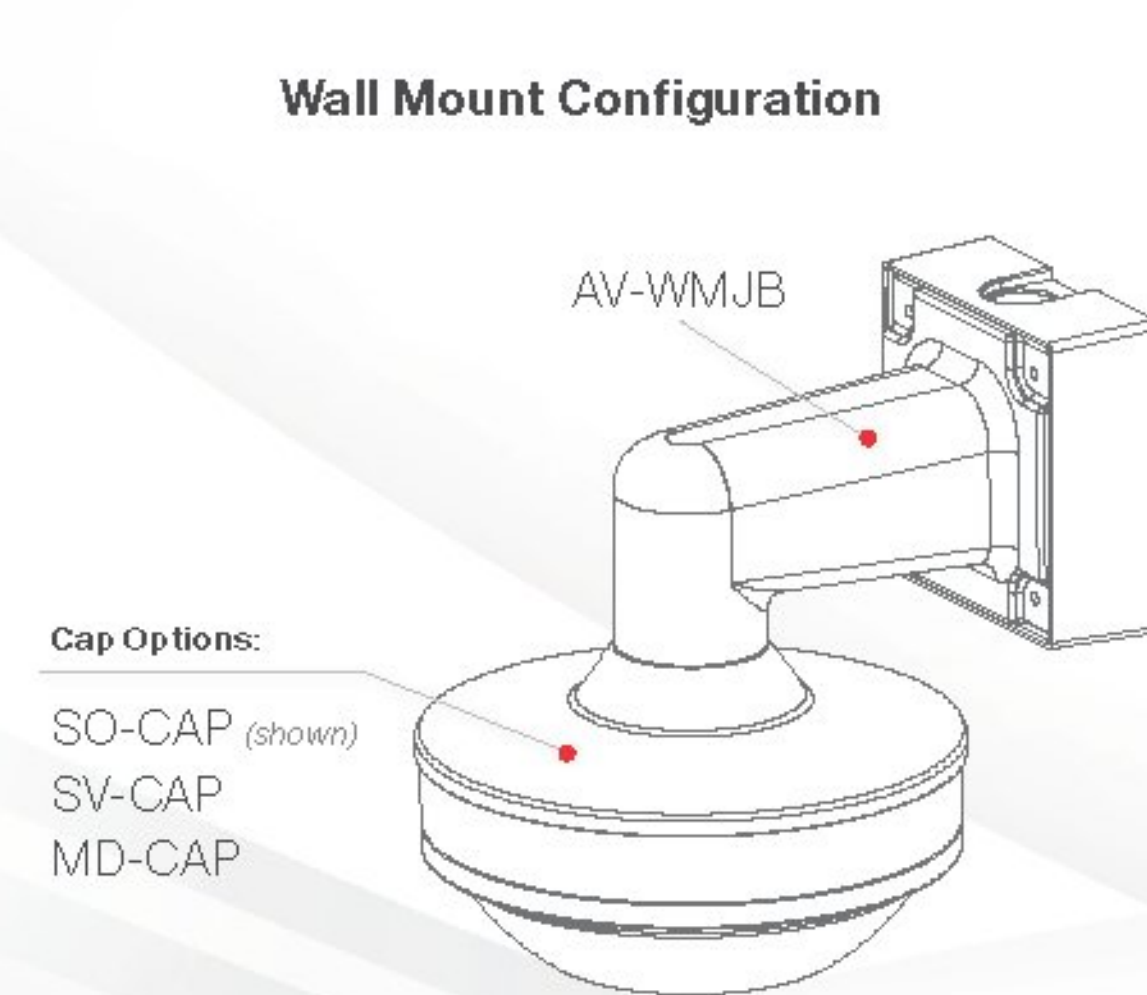
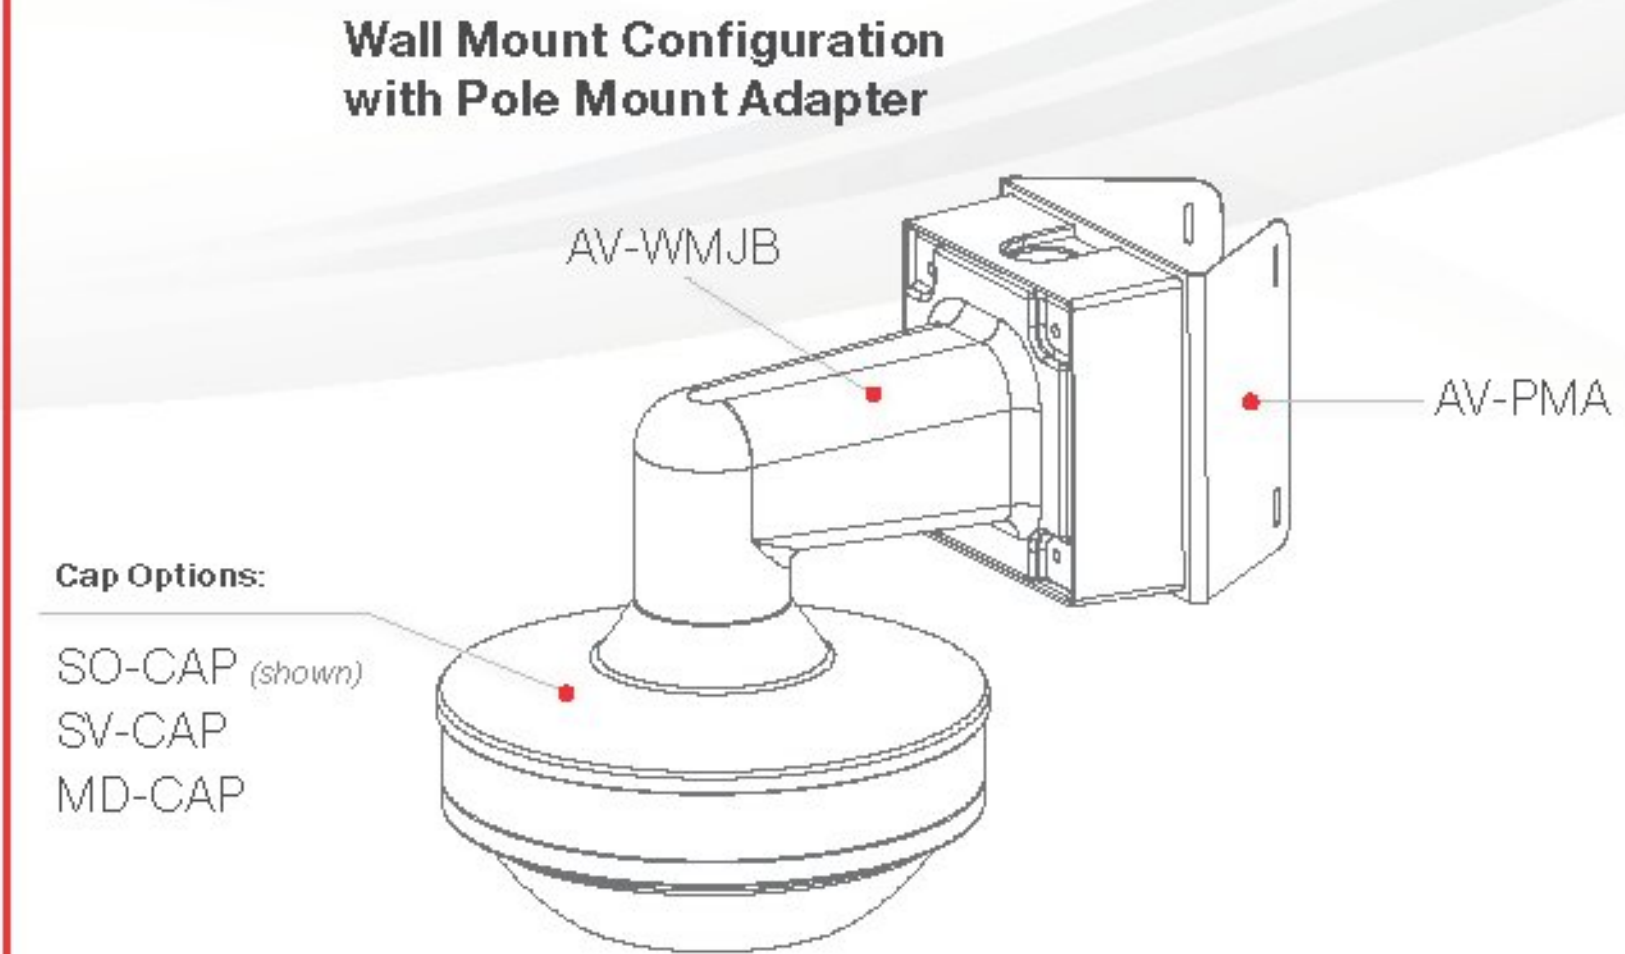


Standard Dome Accessories

Accessories for Indoor/Outdoor Ceiling, Wall, Pole and Corner Mounting Solutions

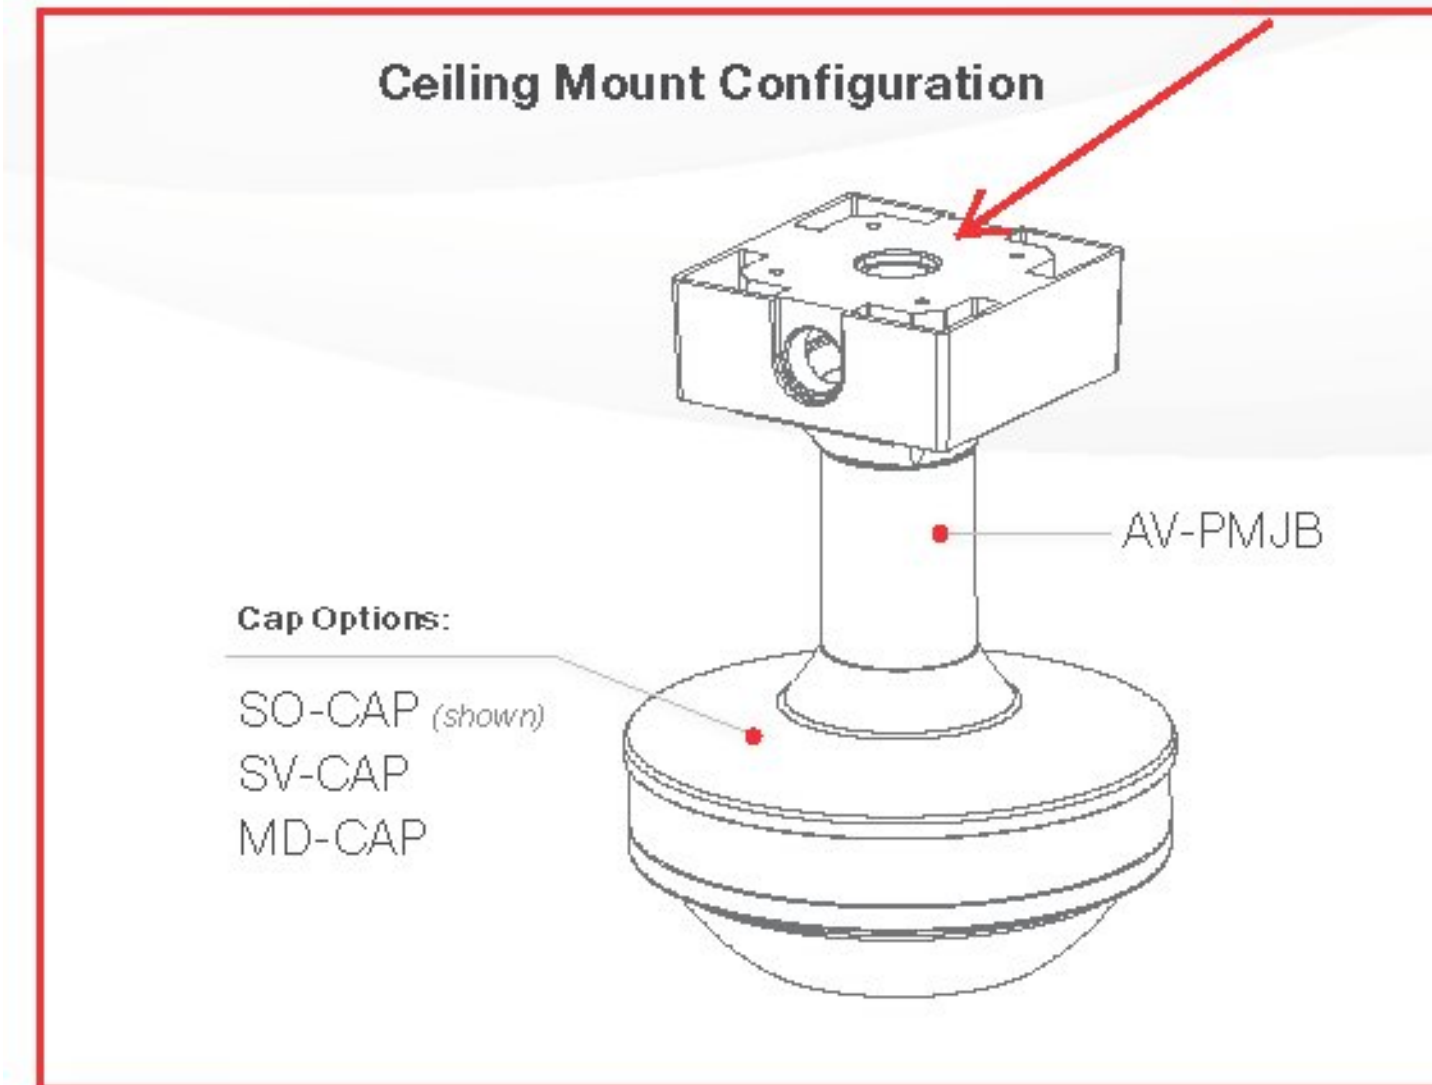

Cap Options:

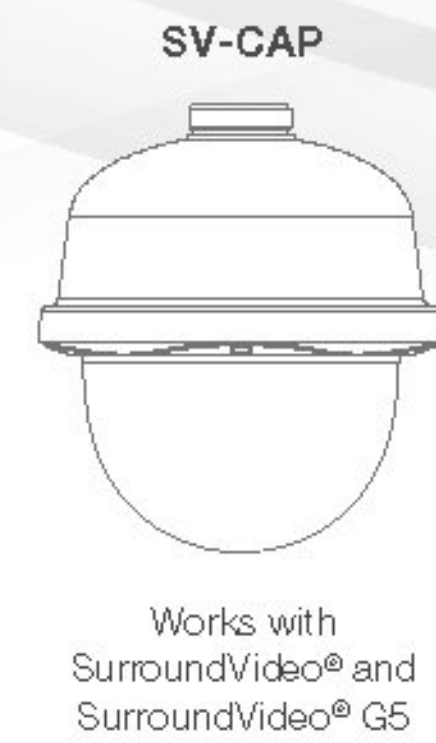

Compatible Cameras:

