

**RECORD PLANS**

Contractor: The Gorman Group - Albany, New York  
 Resident Engineer: Josh Hulett  
 Construction Began: July 13, 2016  
 Construction Complete: October 13, 2017  
 Record Plans By: Josh Hulett / Paul Beyor

I hereby certify that all construction required by this set of drawings has been accomplished as indicated herein.

By: Josh Hulett Josh Hulett - Resident Engineer

Date: December 12, 2017

NOTE: Any further information concerning final quantities, amounts or other details relative to this project may be found at Central Files in the electronic archives.

# STATE OF VERMONT AGENCY OF TRANSPORTATION





## PROPOSED IMPROVEMENT TOWNS OF MIDDLEBURY, NEW HAVEN, WALTHAM AND FERRISBURGH COUNTY OF ADDISON US ROUTE 7 - PRINCIPAL ARTERIAL (NHS)

BEGINNING ON US ROUTE 7 IN THE TOWN OF MIDDLEBURY AT MM 5.713 AND EXTENDING NORTHERLY 18.374 MILES TO MM 7.287 IN THE TOWN OF FERRISBURGH. PROJECT INCLUDES MINOR SEGMENTS OF VT. ROUTE 22A, VT. ROUTE 22A APPROACH RAMP AND FERRISBURGH STATE HIGHWAY ALL IN FERRISBURGH.

| PROJECT DATA                    | LENGTH      |
|---------------------------------|-------------|
| MIDDLEBURY MM 5.713 - MM 7.480  | 1.767 MILES |
| NEW HAVEN MM 0.000 - MM 7.690   | 7.690 MILES |
| WALTHAM MM 0.000 - MM 1.630     | 1.630 MILES |
| FERRISBURGH MM 0.000 - MM 7.287 | 7.287 MILES |

LENGTH OF ROADWAY = (97,014.72 FEET) = 18.374 MILES  
 LENGTH OF PROJECT = (97,014.72 FEET) = 18.374 MILES

WORK TO BE PERFORMED UNDER THIS PROJECT INCLUDES SURFACE PREPARATION INVOLVING PATCHING, POT HOLE REPAIR AND CRACK SEALING AS NECESSARY; MICRO-MILLING, AND OVERLAYING WITH A THIN BITUMINOUS SURFACE TREATMENT ON THE EXISTING TYPICAL, TWO NEW DILEMMA ZONE DETECTION SYSTEMS, A RAIL CROSSING IMPROVEMENT/RECONSTRUCTION IN FERRISBURGH; AND OTHER HIGHWAY RELATED ITEMS.

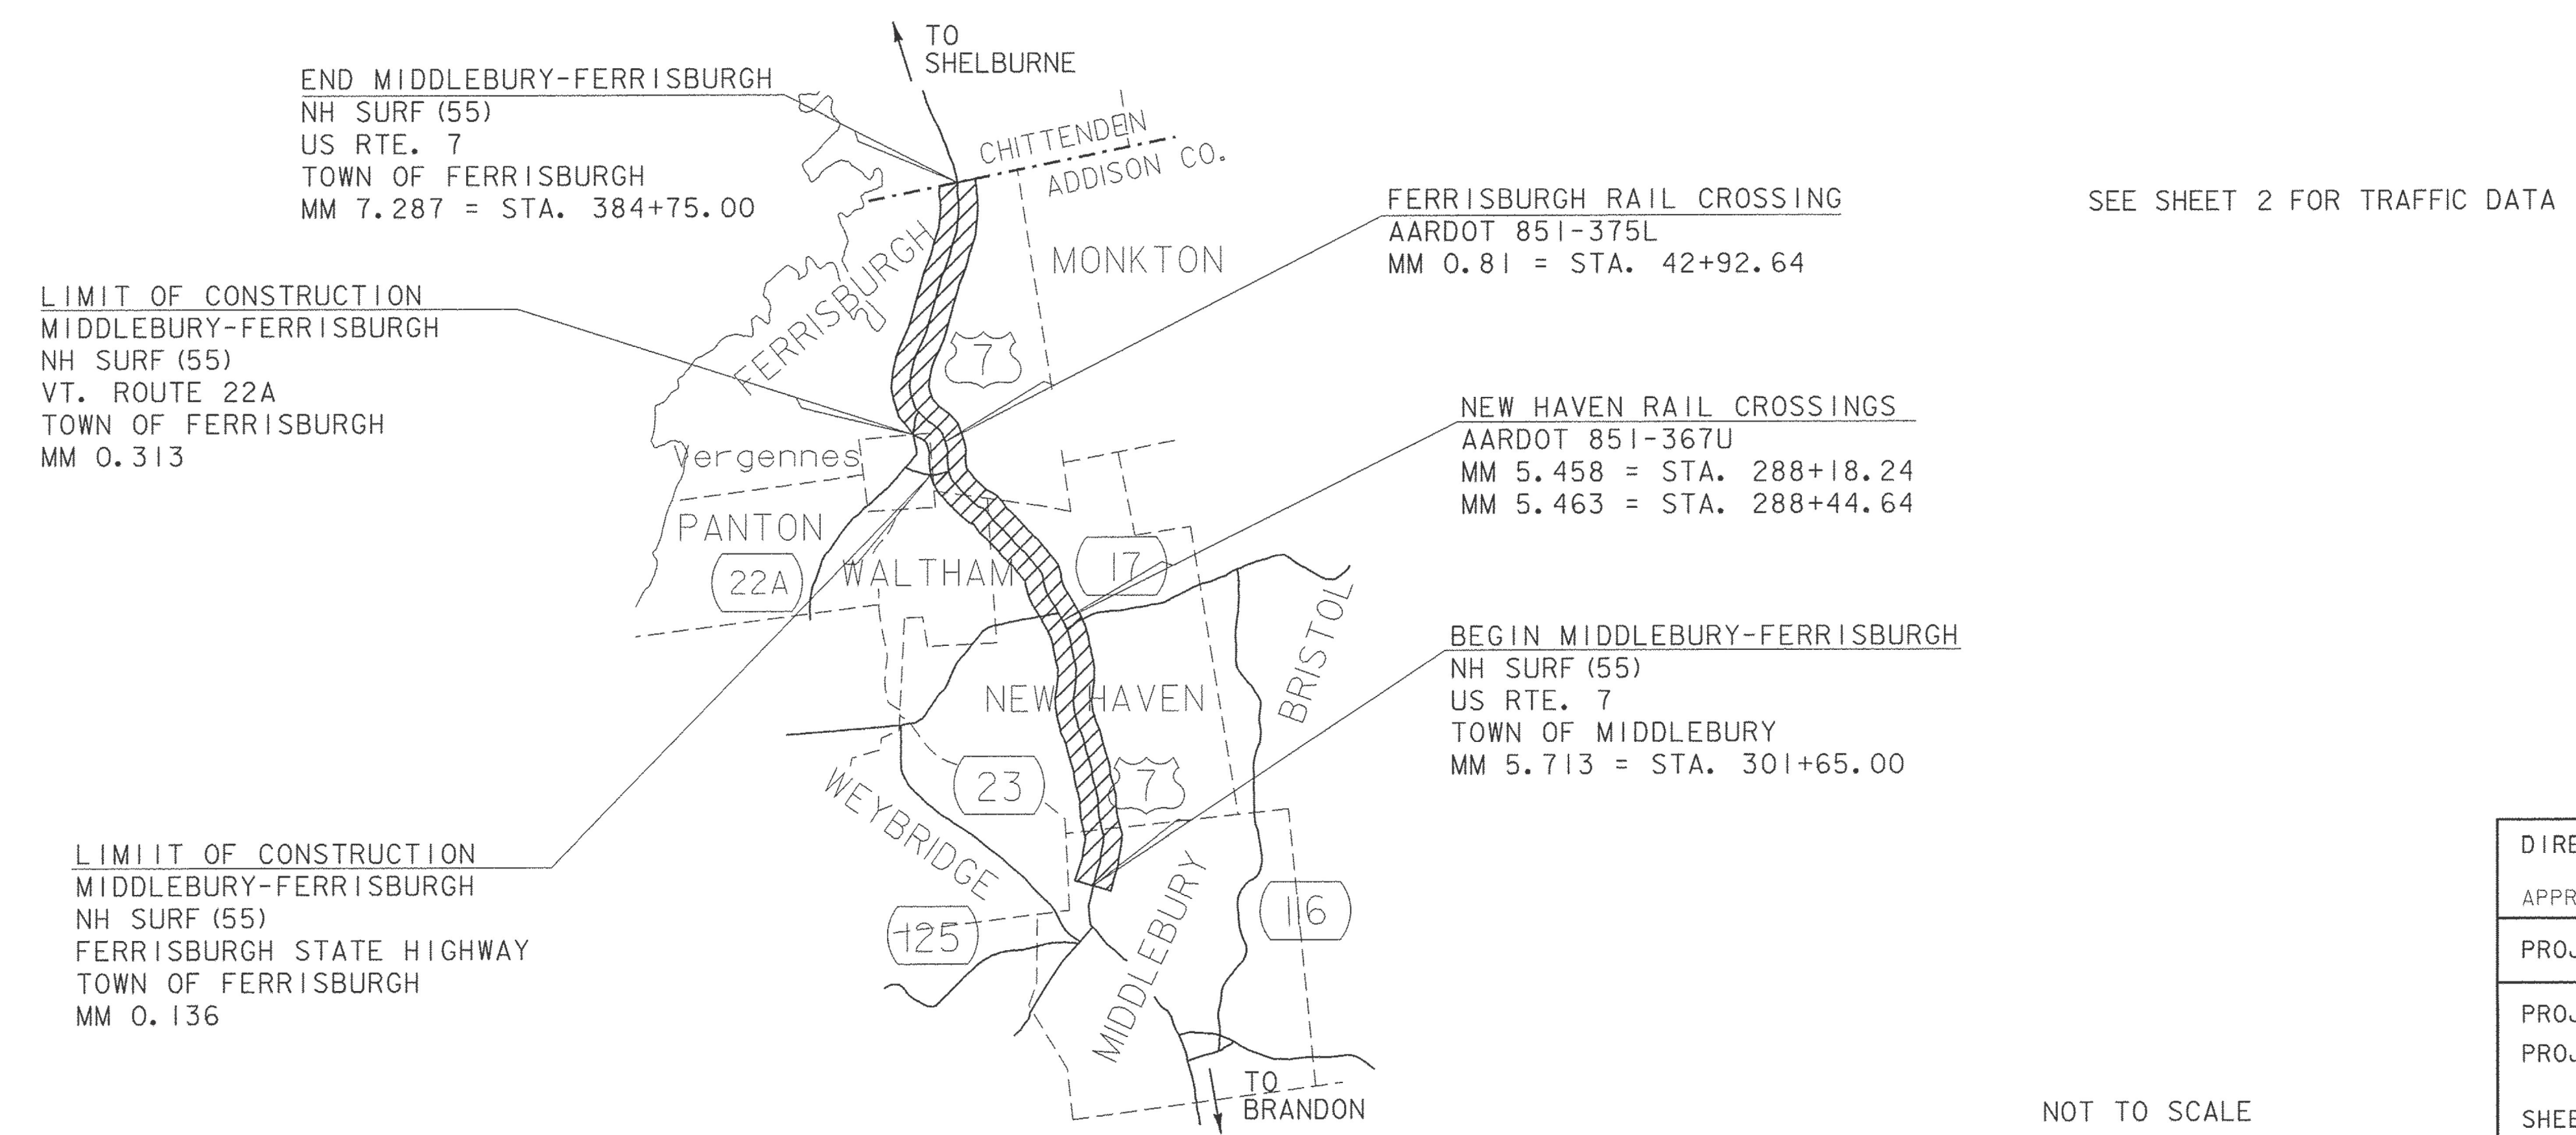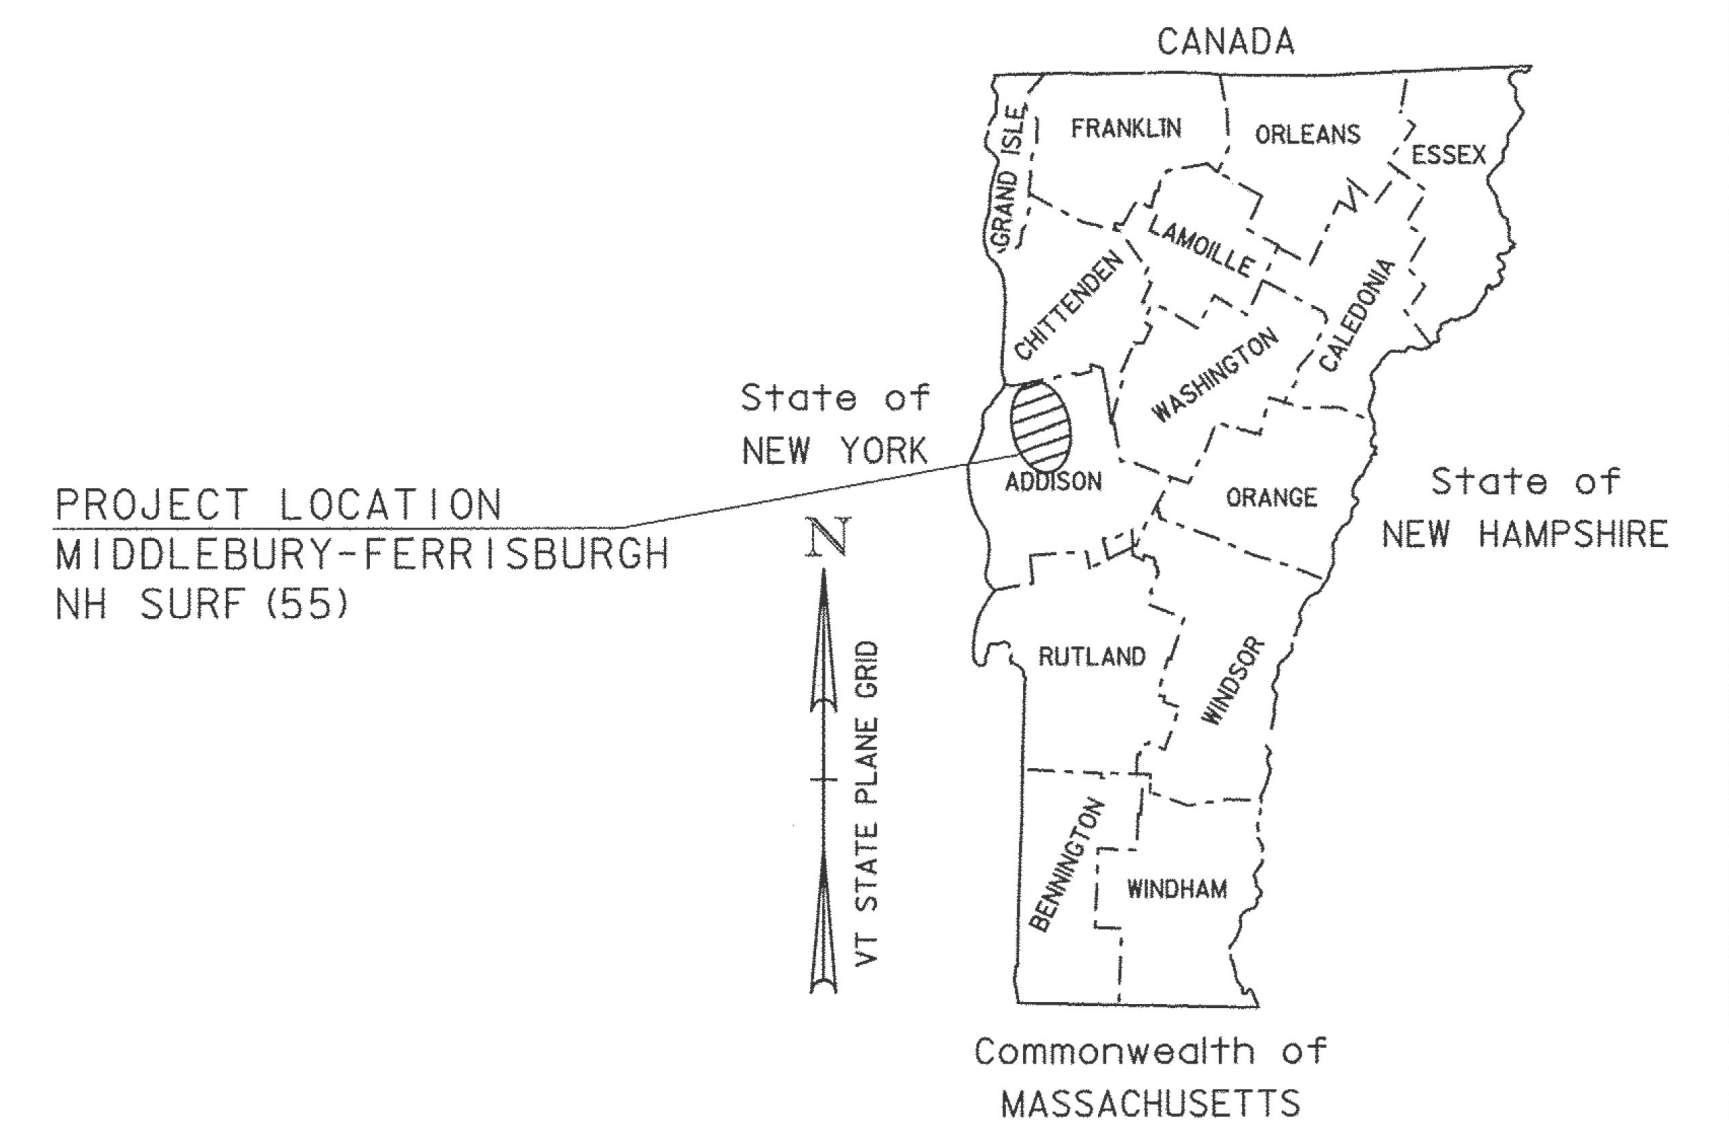

SEE SHEET 2 FOR TRAFFIC DATA

CONSTRUCTION IS TO BE CARRIED ON IN ACCORDANCE WITH THESE PLANS AND THE STANDARD SPECIFICATIONS FOR CONSTRUCTION DATED 2011, AS APPROVED BY THE FEDERAL HIGHWAY ADMINISTRATION ON JULY 20, 2011 FOR USE ON THIS PROJECT, INCLUDING ALL SUBSEQUENT REVISIONS AND SUCH REVISED SPECIFICATIONS AND SPECIAL PROVISIONS AS ARE INCORPORATED IN THESE PLANS.

|                                     |     |
|-------------------------------------|-----|
| QUALITY ASSURANCE PROGRAM : LEVEL I |     |
| SURVEYED BY :                       | N/A |
| SURVEYED DATE :                     | N/A |
| DATUM                               |     |
| VERTICAL                            | N/A |
| HORIZONTAL                          | N/A |

LIMIT OF CONSTRUCTION  
 MIDDLEBURY-FERRISBURGH  
 NH SURF (55)  
 FERRISBURGH STATE HIGHWAY  
 TOWN OF FERRISBURGH  
 MM 0.136

NOT TO SCALE

|                                                |                        |
|------------------------------------------------|------------------------|
| DIRECTOR OF PROJECT DELIVERY                   |                        |
| APPROVED <u>[Signature]</u>                    | DATE <u>3/30/2016</u>  |
| PROJECT MANAGER : JONATHAN C. HARRINGTON, P.E. |                        |
| PROJECT NAME :                                 | MIDDLEBURY-FERRISBURGH |
| PROJECT NUMBER :                               | NH SURF (55)           |
| SHEET 1 OF 96 SHEETS                           |                        |