


TEMPORARY 4 INCH WHITE LINE, PAINT  
 SPECIAL PROVISION (DURABLE 4 INCH WHITE LINE, POLYUREA)(28 MILS)  
 (ALL LINES WILL INCLUDE EDGE LINE BREAKS AND  
 RADIUS FOR TOWN HIGHWAYS)  
 MIDDLEBURY:  
 STA. 336+00.0 - STA. 351+00.0 LT & RT

TEMPORARY 4 INCH YELLOW LINE, PAINT  
 SPECIAL PROVISION (DURABLE 4 INCH YELLOW LINE, POLYUREA)(28 MILS)  
 (ALL LINES WILL INCLUDE C/L BREAKS FOR  
 TOWN HIGHWAYS) S=SOLID, D=DASHED  
 MIDDLEBURY:  
 STA. 336+00.0 - STA. 351+00.0 LT C RT  
 S - S

TEMPORARY LETTER OR SYMBOL, PAINT  
 SPECIAL PROVISION (DURABLE LETTER OR SYMBOL, POLYUREA)(28 MILS) OR  
 DURABLE LETTER OR SYMBOL, THERMOPLASTIC  
 MIDDLEBURY:  
 STA. 347+21.00 RT, "SCHOOL" (6 EA)

Not installed → MILLED RUMBLE STRIPS (CENTERLINE)  
 MIDDLEBURY:  
 STA. 341+09.00 - STA. 348+48.00  
 STA. 350+59.00 - STA. 351+00.00  
 STA 350+60

The rumble strips were installed incorrectly and will not be paid for. The Resident Engineer informed L&D before they started on 9/1/16 to make sure they were installing the rumble per VTrans standard, L&D was told to test their truck before starting the work. The rumbles were installed incorrectly on both 9/1 and 9/2. No Payment for the 3,025 LF

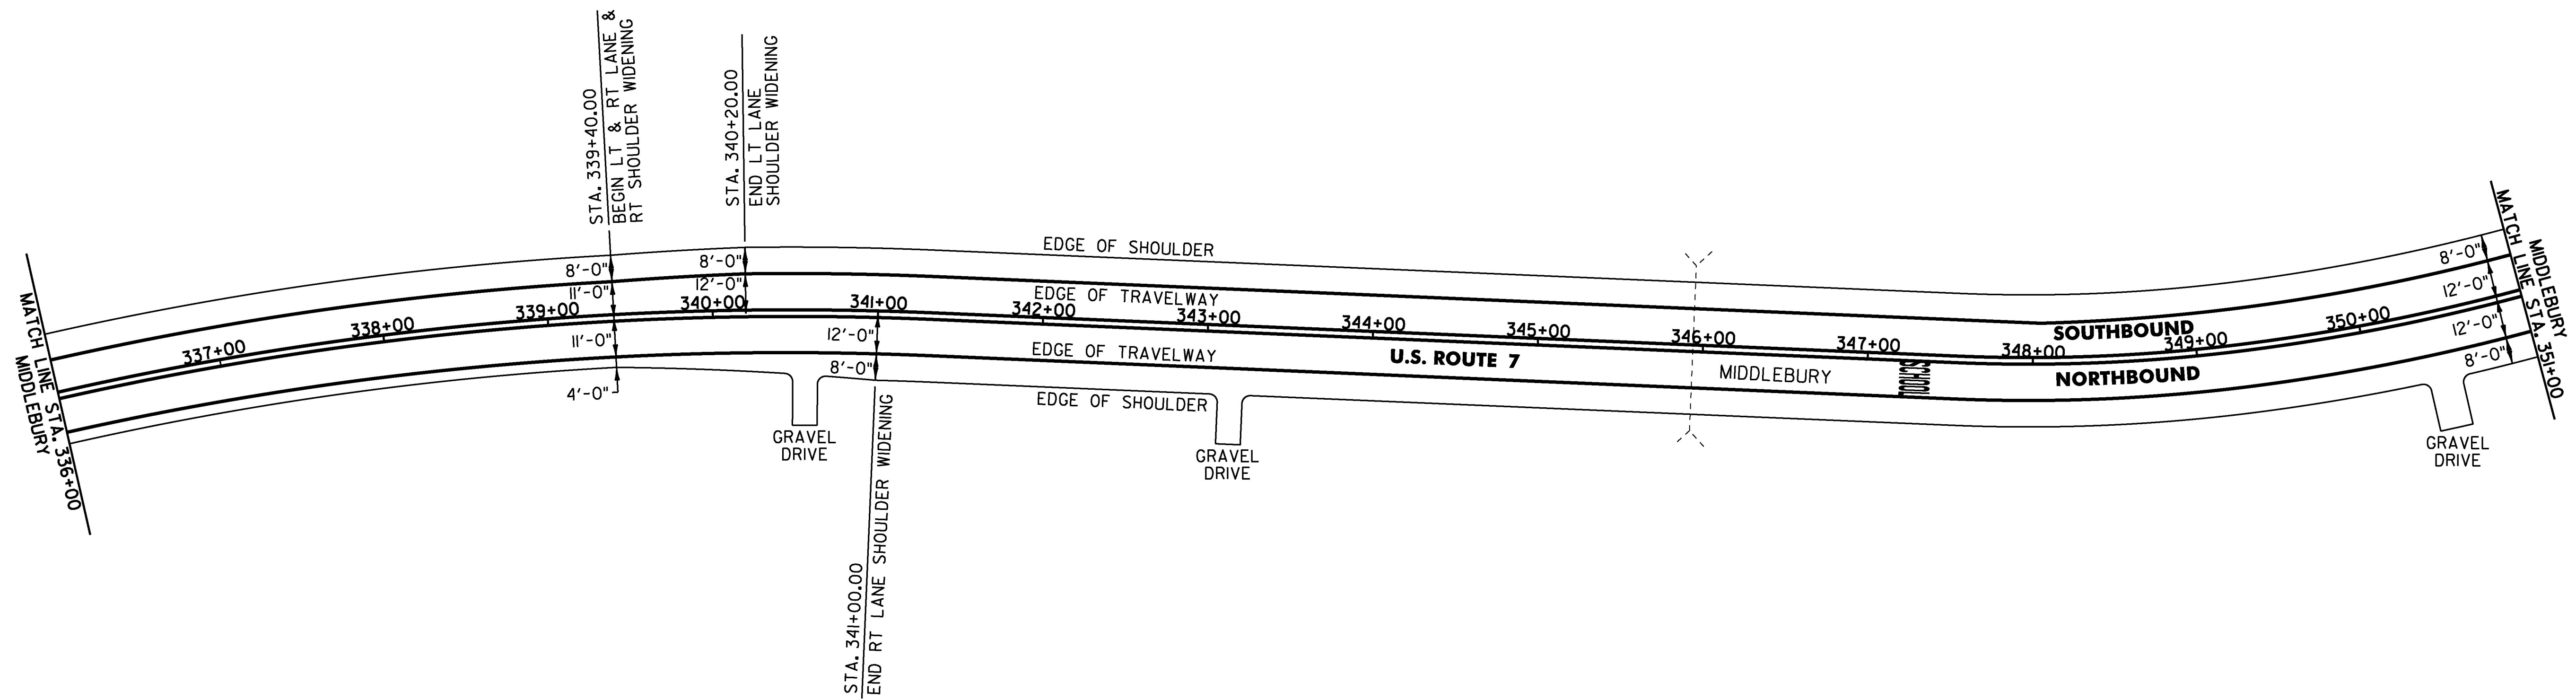

NOT TO SCALE

PROJECT NAME:	MIDDLEBURY-FERRISBURGH
PROJECT NUMBER:	NH SURF(55)
FILE NAME:	pi5v015.dgn
PROJECT LEADER:	J. HARRINGTON
DESIGNED BY:	L. BULLOCK
PLAN SHEET 4	
PLOT DATE:	16-MAR-2016
DRAWN BY:	L. BULLOCK
CHECKED BY:	J. HARRINGTON
SHEET	18 OF 96