

TEMPORARY 4 INCH WHITE LINE, PAINT
 SPECIAL PROVISION (DURABLE 4 INCH WHITE LINE, POLYUREA)(28 MILS)
 (ALL LINES WILL INCLUDE EDGE LINE BREAKS AND
 RADIUS FOR TOWN HIGHWAYS)
 MIDDLEBURY:
 STA. 351+00.0 - STA. 367+00.0 LT & RT


TEMPORARY 24 INCH STOP BAR, PAINT
 SPECIAL PROVISION (DURABLE 24 INCH STOP BAR, POLYUREA)(28 MILS) OR
 DURABLE 24 INCH STOP BAR, THERMOPLASTIC
 MIDDLEBURY:
 STA. 351+64.80 LT, TH-73
 STA. 351+64.80 RT, TH-9

TEMPORARY LETTER OR SYMBOL, PAINT
 SPECIAL PROVISION (DURABLE LETTER OR SYMBOL, POLYUREA)(28 MILS) OR
 DURABLE LETTER OR SYMBOL, THERMOPLASTIC
 MIDDLEBURY:
 STA. 351+64.80 LT, TH-73, "STOP" (4 EA)
 STA. 351+64.80 RT, TH-9, "STOP" (4 EA)
 STA. 358+00.00 LT, "SCHOOL" (6 EA)

TEMPORARY 4 INCH YELLOW LINE, PAINT
 SPECIAL PROVISION (DURABLE 4 INCH YELLOW LINE, POLYUREA)(28 MILS)
 (ALL LINES WILL INCLUDE C/L BREAKS FOR
 TOWN HIGHWAYS) S=SOLID, D=DASHED
 MIDDLEBURY:
 STA. 351+64.80 DOUBLE SOLID LT, TH-73
 STA. 351+64.80 DOUBLE SOLID RT, TH-9
 STA. 351+00.0 - STA. 357+50.0
 STA. 357+50.0 - STA. 365+50.0
 STA. 365+50.0 - STA. 367+00.0

MILLED RUMBLE STRIPS (CENTERLINE)
 MIDDLEBURY:
 STA. 351+00.00 - STA. 351+44.00 351+70
 352+25 STA. 351+84.00 - STA. 359+04.00 361+40
 365+50 STA. 365+38.00 - STA. 367+00.00
 See Rumble Strip non-payment note on Page #18

LT	CL	RT
S	-	S
S	-	D
-	D	-

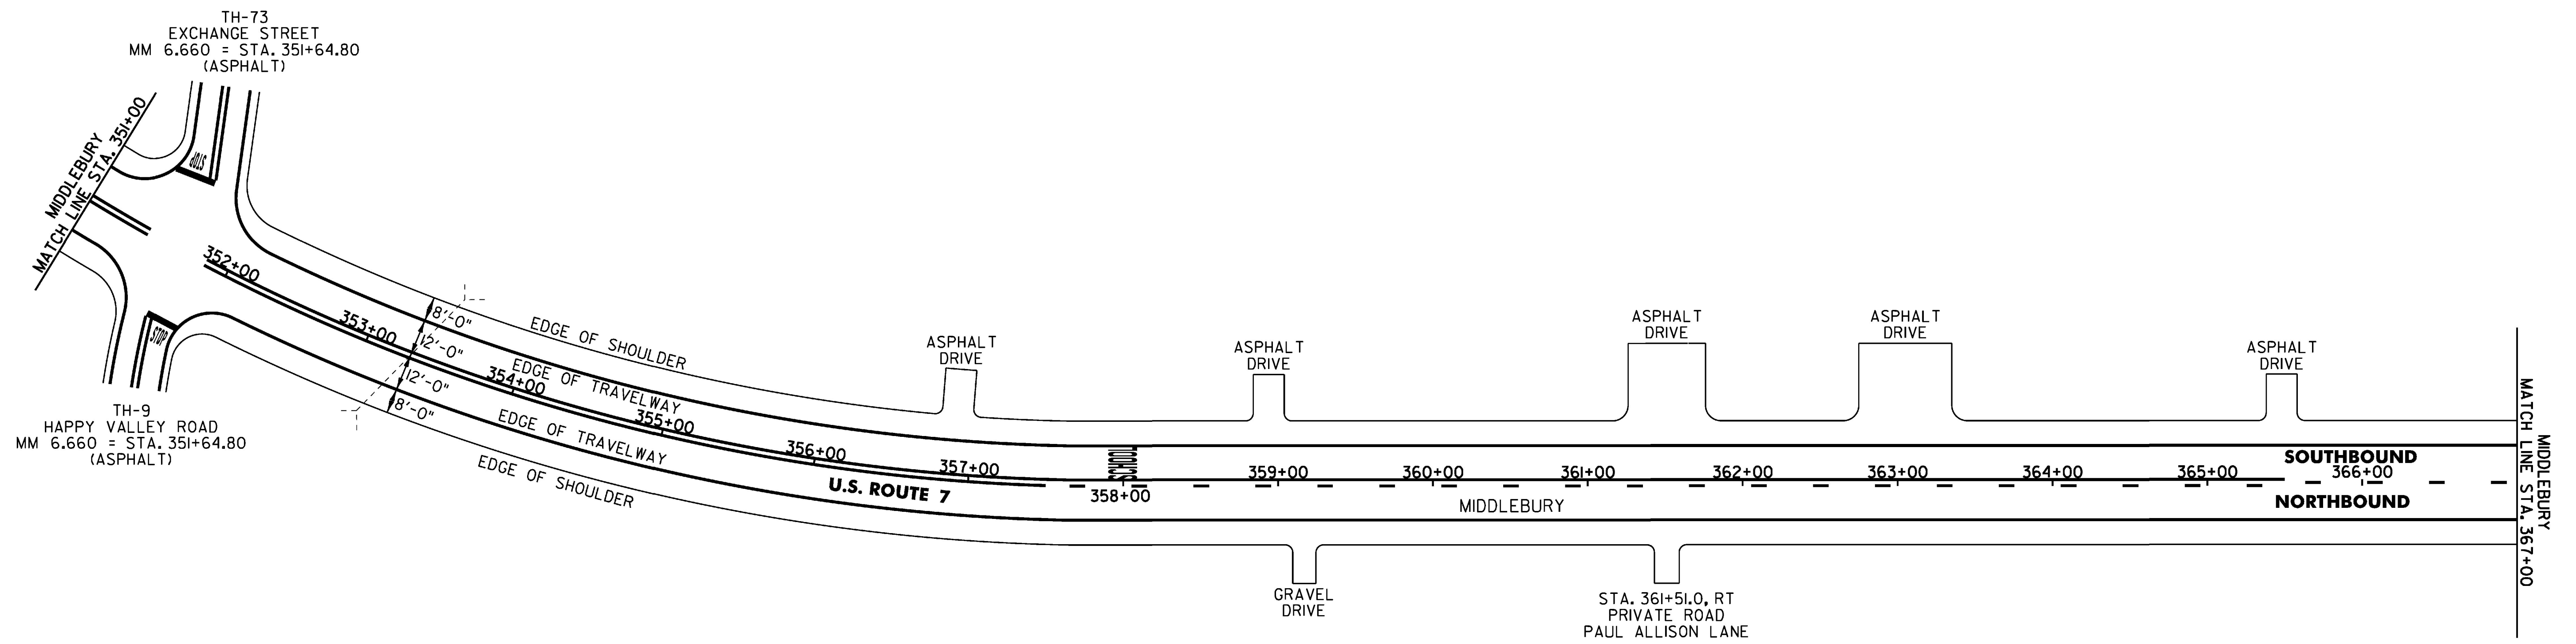

NOT TO SCALE

PROJECT NAME:	MIDDLEBURY-FERRISBURGH
PROJECT NUMBER:	NH SURF(55)
FILE NAME:	pl5v015.dgn
PROJECT LEADER:	J. HARRINGTON
DESIGNED BY:	L. BULLOCK
PLAN SHEET 5	
PLOT DATE:	16-MAR-2016
DRAWN BY:	L. BULLOCK
CHECKED BY:	J. HARRINGTON
SHEET	19 OF 96