


TEMPORARY 4 INCH WHITE LINE, PAINT
 SPECIAL PROVISION (DURABLE 4 INCH WHITE LINE, POLYUREA)(28 MILS)
 (ALL LINES WILL INCLUDE EDGE LINE BREAKS AND
 RADIUS FOR TOWN HIGHWAYS)
 MIDDLEBURY:
 STA. 367+00.0 - STA. 383+00.0 LT & RT

MILLED RUMBLE STRIPS (CENTERLINE)
 MIDDLEBURY:
 STA. 367+00.00 - STA. 374+88.00 377+25 See Rumble Strip non-payment
 382+25 STA. 382+27.00 - STA. 383+00.00 note on Page #18

TEMPORARY 4 INCH YELLOW LINE, PAINT
 SPECIAL PROVISION (DURABLE 4 INCH YELLOW LINE, POLYUREA)(28 MILS)
 (ALL LINES WILL INCLUDE C/L BREAKS FOR
 TOWN HIGHWAYS) S=SOLID, D=DASHED
 MIDDLEBURY: LT C RT
 STA. 367+00.0 - STA. 371+50.0 - D - D -
 STA. 371+50.0 - STA. 379+50.0 D - S
 STA. 379+50.0 - STA. 383+00.0 S - D

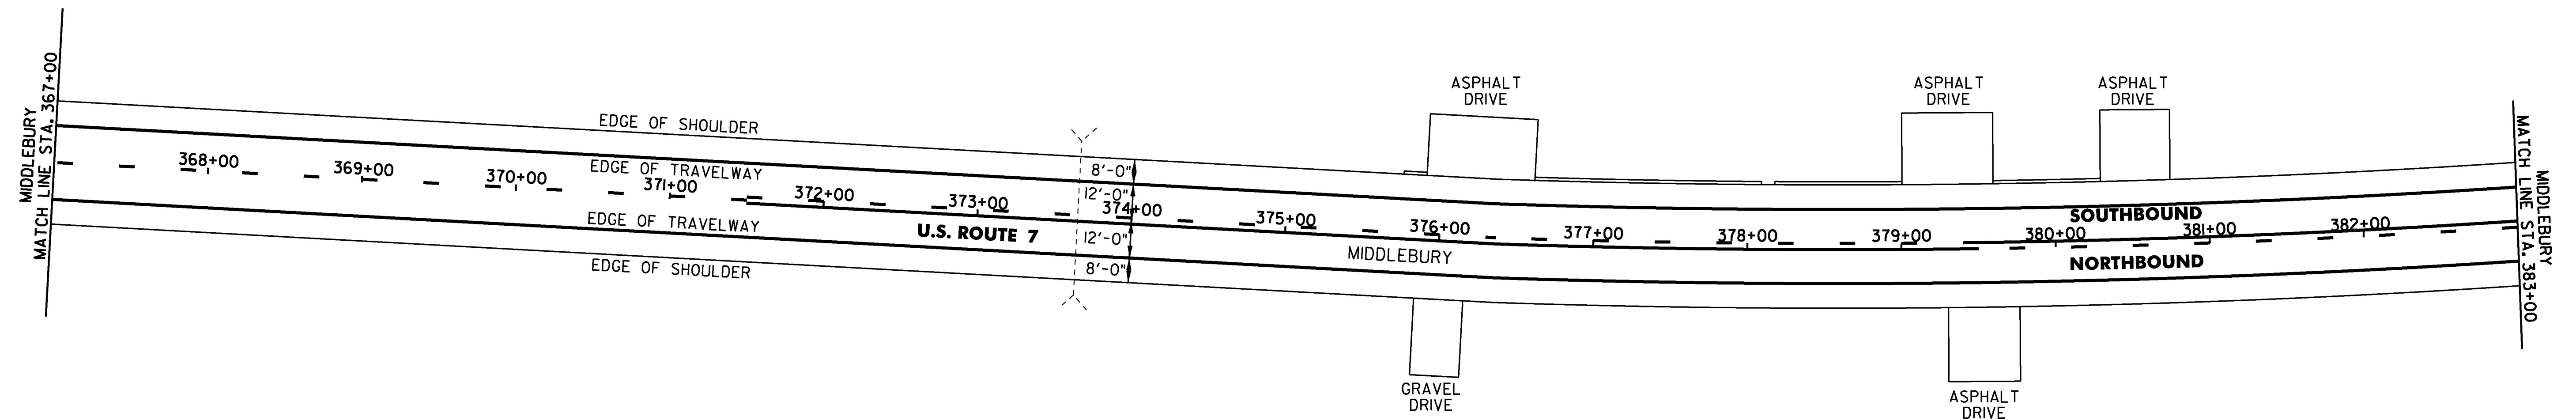

NOT TO SCALE

PROJECT NAME: MIDDLEBURY-FERRISBURGH	
PROJECT NUMBER: NH SURF(55)	
FILE NAME: pl5v015.dgn	PLOT DATE: 16-MAR-2016
PROJECT LEADER: J. HARRINGTON	DRAWN BY: L. BULLOCK
DESIGNED BY: L. BULLOCK	CHECKED BY: J. HARRINGTON
PLAN SHEET 6	SHEET 20 OF 96