


TEMPORARY 4 INCH WHITE LINE, PAINT
 SPECIAL PROVISION (DURABLE 4 INCH WHITE LINE, POLYUREA)(28 MILS)
 (ALL LINES WILL INCLUDE EDGE LINE BREAKS AND
 RADIUS FOR TOWN HIGHWAYS)
 MIDDLEBURY:
 STA. 383+00.0 - STA. 394+89.12 LT & RT
 NEW HAVEN:
 STA. 0+00.0 - STA. 4+00.0 LT & RT

TEMPORARY 4 INCH YELLOW LINE, PAINT
 SPECIAL PROVISION (DURABLE 4 INCH YELLOW LINE, POLYUREA)(28 MILS)
 (ALL LINES WILL INCLUDE C/L BREAKS FOR
 TOWN HIGHWAYS) S=SOLID, D=DASHED
 MIDDLEBURY:
 STA. 383+00.0 - STA. 387+50.0 LT C RT
 STA. 387+50.0 - STA. 390+00.0 S D D
 STA. 390+00.0 - STA. 394+89.12 D - S
 NEW HAVEN:
 STA. 0+00.0 - STA. 4+00.0 D - S

MILLED RUMBLE STRIPS (CENTERLINE)
 MIDDLEBURY:
 STA. 383+00.00 - STA. 391+78.00 390+50
 STA. 394+42.00 - STA. 394+89.12
 STA. 390+50 - STA. 391+00
 NEW HAVEN:
 STA. 0+00.00 - STA. 4+00.00

See Rumble Strip non-payment
 note on Page #18

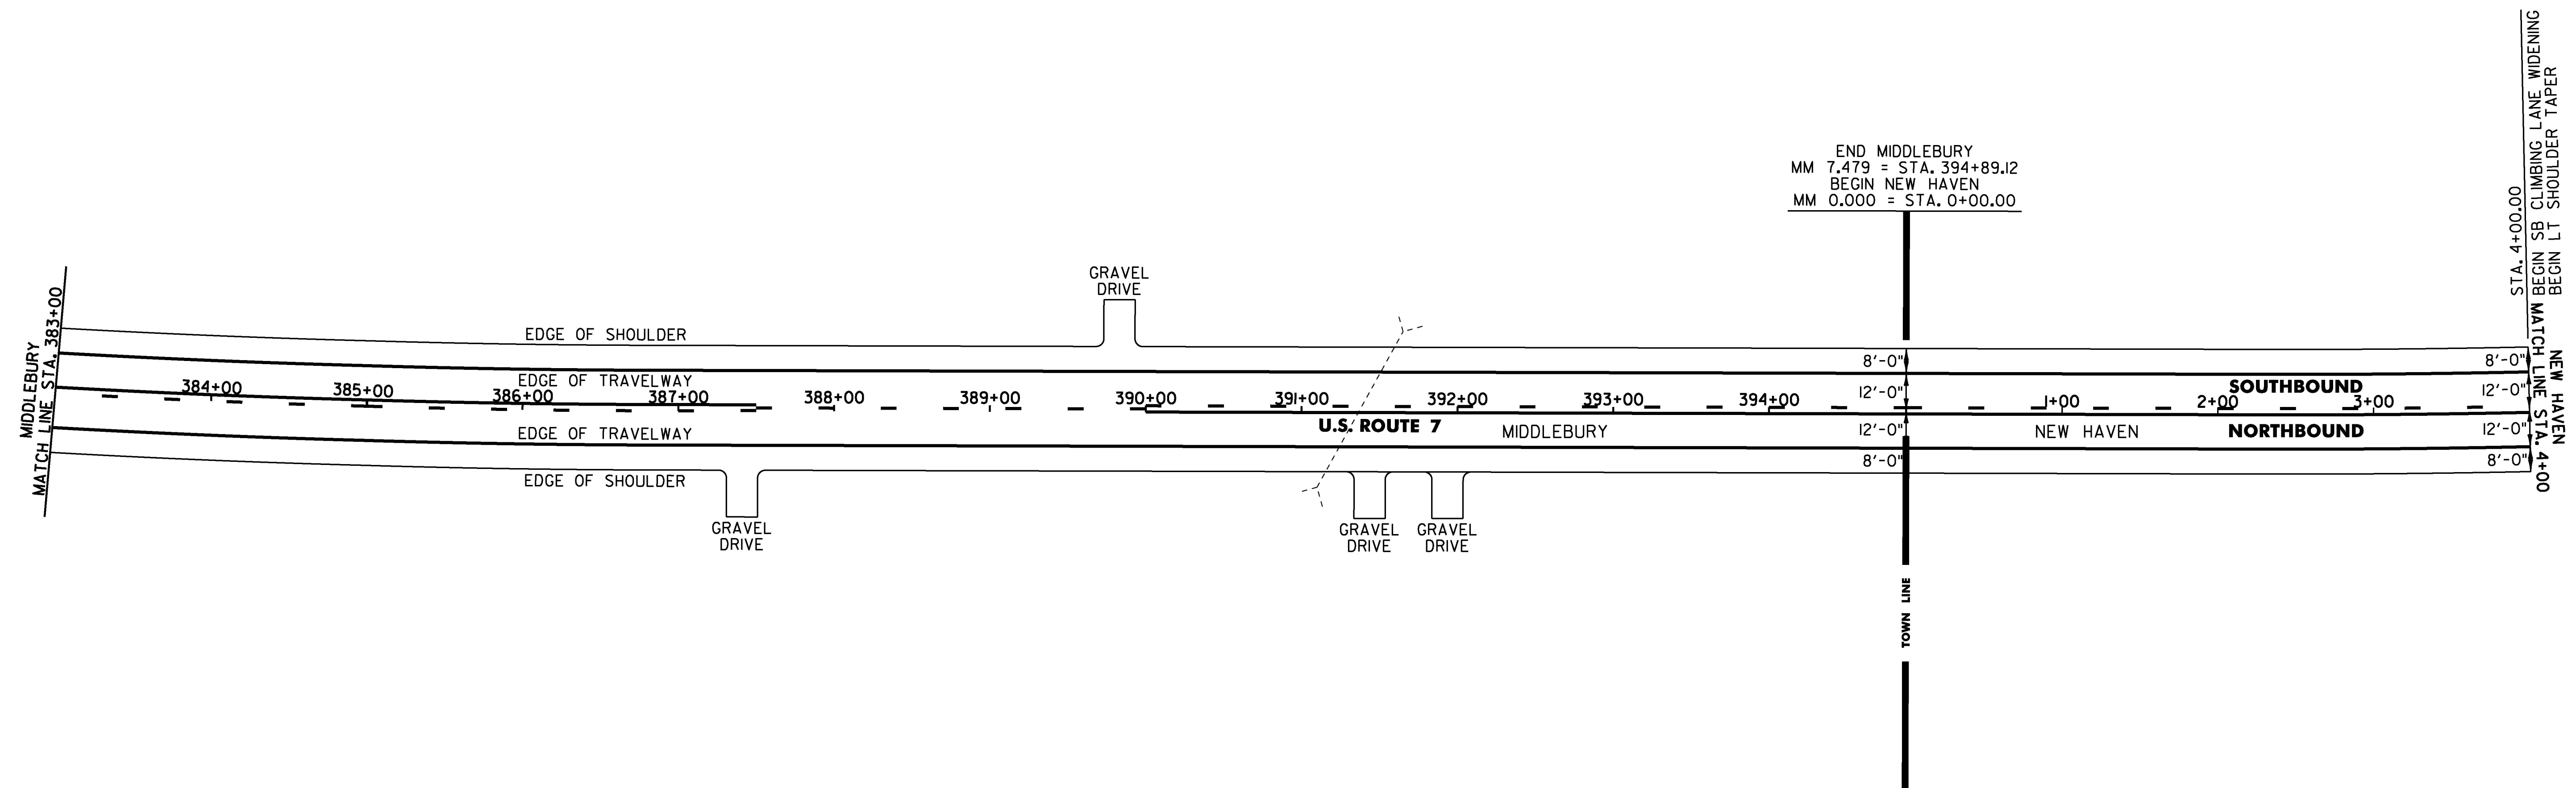

NOT TO SCALE

PROJECT NAME: MIDDLEBURY-FERRISBURGH	
PROJECT NUMBER: NH SURF(55)	
FILE NAME: p15v015.dgn	PLOT DATE: 16-MAR-2016
PROJECT LEADER: J. HARRINGTON	DRAWN BY: L. BULLOCK
DESIGNED BY: L. BULLOCK	CHECKED BY: J. HARRINGTON
PLAN SHEET 7	SHEET 21 OF 96