

TEMPORARY 4 INCH WHITE LINE, PAINT
 SPECIAL PROVISION (DURABLE 4 INCH WHITE LINE, POLYUREA)(28 MILS)
 (ALL LINES WILL INCLUDE EDGE LINE BREAKS AND
 RADIUS FOR TOWN HIGHWAYS)
 NEW HAVEN:
 STA. 20+00.0 - STA. 35+00.0 LT & RT
 STA. 20+00.0 - STA. 35+00.0 DASHED LT

TEMPORARY 4 INCH YELLOW LINE, PAINT
 SPECIAL PROVISION (DURABLE 4 INCH YELLOW LINE, POLYUREA)(28 MILS)
 (ALL LINES WILL INCLUDE C/L BREAKS FOR
 TOWN HIGHWAYS) S=SOLID, D=DASHED
 NEW HAVEN:
 STA. 20+00.0 - STA. 26+66.0 LT C RT S - S
 STA. 32+74.0 - STA. 35+00.0 S - S
 STA. 29+19.84 DOUBLE SOLID LT, TH-32
 STA. 29+35.68 DOUBLE SOLID RT, TH-2
 STA. 26+66 - STA. 29+04 DOUBLE SOLID MEDIAN LT/RT
 STA. 29+56 - STA. 32+74 DOUBLE SOLID MEDIAN LT/RT


TEMPORARY 24 INCH STOP BAR, PAINT
 SPECIAL PROVISION (DURABLE 24 INCH STOP BAR, POLYUREA)(28 MILS) OR
 DURABLE 24 INCH STOP BAR, THERMOPLASTIC
 NEW HAVEN:
 STA. 29+19.84 LT, TH-32
 STA. 29+35.68 RT, TH-2

TEMPORARY 8 INCH YELLOW LINE, PAINT
 SPECIAL PROVISION (DURABLE 8 INCH YELLOW LINE, POLYUREA)(28 MILS)
 NEW HAVEN:
 STA. 26+66 C/L - STA. 29+04 C/L (HATCHED MEDIAN)
 STA. 29+56 C/L - STA. 32+74 C/L (HATCHED MEDIAN)

TEMPORARY LETTER OR SYMBOL, PAINT
 SPECIAL PROVISION (DURABLE LETTER OR SYMBOL, POLYUREA)(28 MILS) OR
 DURABLE LETTER OR SYBOML, THERMOPLASTIC
 NEW HAVEN:
 STA. 29+19.84 LT, TH-32, "STOP" (4 EA)
 STA. 29+35.68 RT, TH-2, "STOP" (4 EA)

TEMPORARY 8 INCH WHITE LINE, PAINT
 SPECIAL PROVISION (DURABLE 8 INCH WHITE LINE, POLYUREA)(28 MILS)
 NEW HAVEN:
 STA. 29+30 RT. - STA. 29+80 RT. (TH 2 HATCHED SHOULDER)

MILLED RUMBLE STRIPS (CENTERLINE)
 NEW HAVEN:
 STA. 20+00.00 - STA. 29+00.00 28+50
 29+62 STA. 29+56.00 - STA. 35+00.00

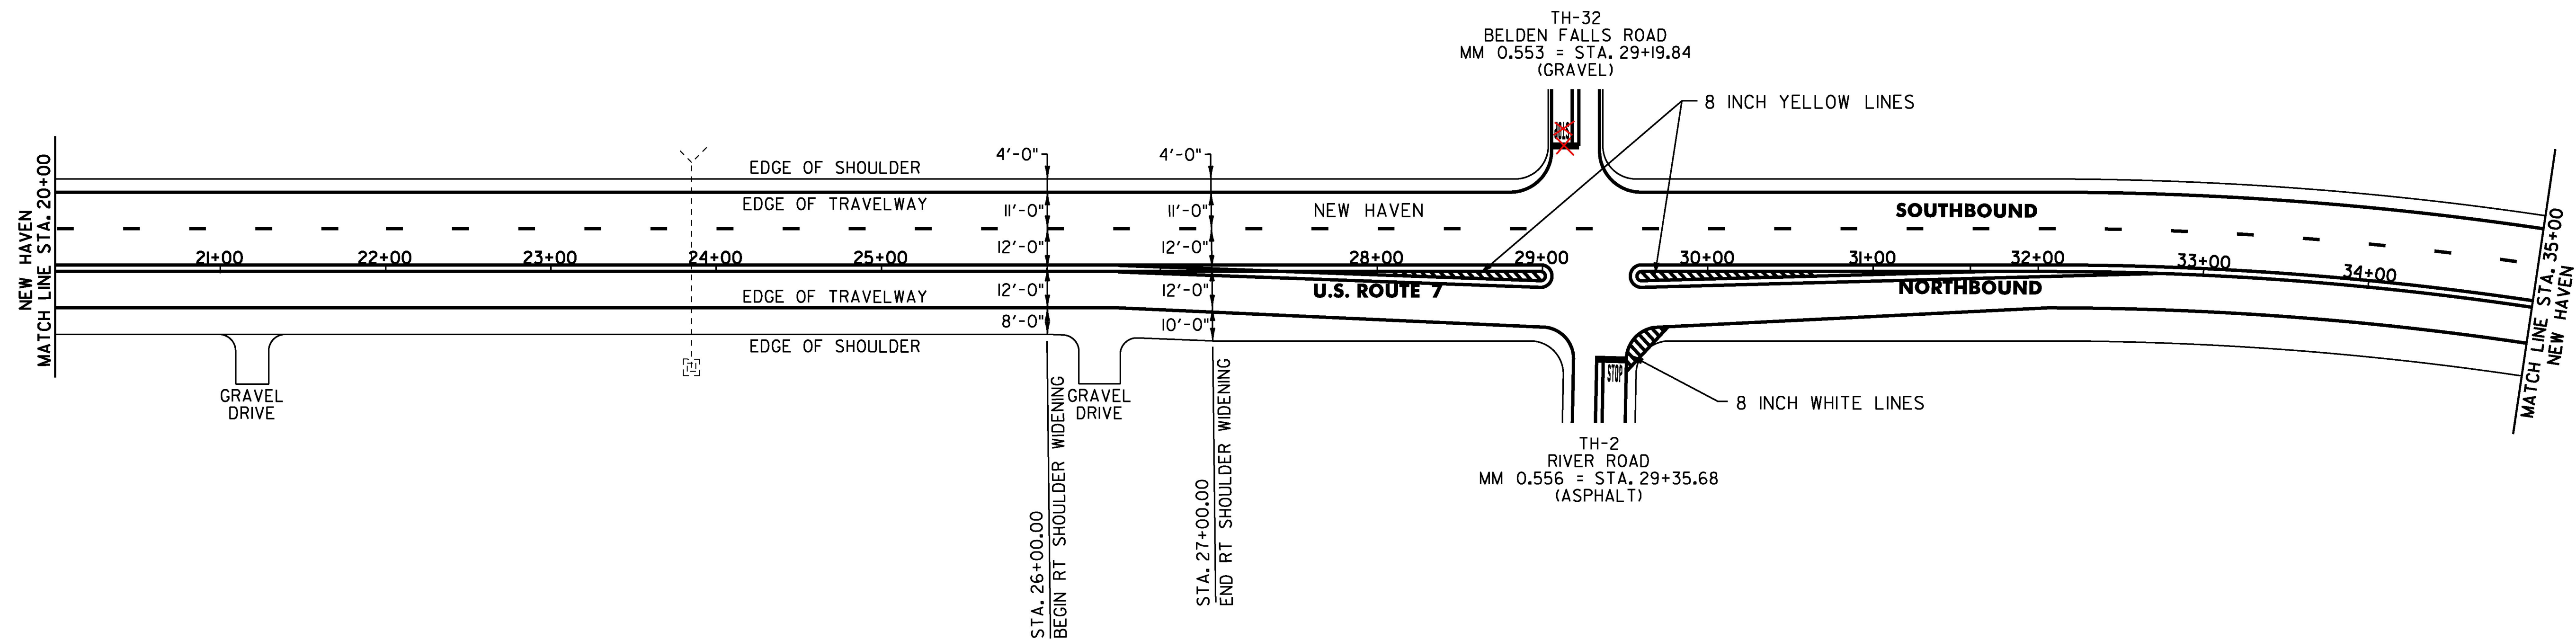

NOT TO SCALE

PROJECT NAME:	MIDDLEBURY-FERRISBURGH
PROJECT NUMBER:	NH SURF(55)
FILE NAME:	pl5v0i5.dgn
PROJECT LEADER:	J. HARRINGTON
DESIGNED BY:	L. BULLOCK
PLAN SHEET 9	
PLOT DATE:	16-MAR-2016
DRAWN BY:	L. BULLOCK
CHECKED BY:	J. HARRINGTON
SHEET	23 OF 96