


TEMPORARY 4 INCH WHITE LINE, PAINT
 SPECIAL PROVISION (DURABLE 4 INCH WHITE LINE, POLYUREA)(28 MILS)
 (ALL LINES WILL INCLUDE EDGE LINE BREAKS AND
 RADIUS FOR TOWN HIGHWAYS)
 NEW HAVEN:
 STA. 67+00.0 - STA. 83+00.0 LT & RT
 STA. 79+00.0 - STA. 83+00.0 DASHED RT

MILLED RUMBLE STRIPS (CENTERLINE)
 NEW HAVEN:
 STA. 67+00.00 - STA. 83+00.00

TEMPORARY 4 INCH YELLOW LINE, PAINT
 SPECIAL PROVISION (DURABLE 4 INCH YELLOW LINE, POLYUREA)(28 MILS)
 (ALL LINES WILL INCLUDE C/L BREAKS FOR
 TOWN HIGHWAYS) S=SOLID, D=DASHED
 NEW HAVEN: LT C RT
 STA. 67+00.0 - STA. 72+00.0 S - D
 STA. 72+00.0 - STA. 83+00.0 S - S

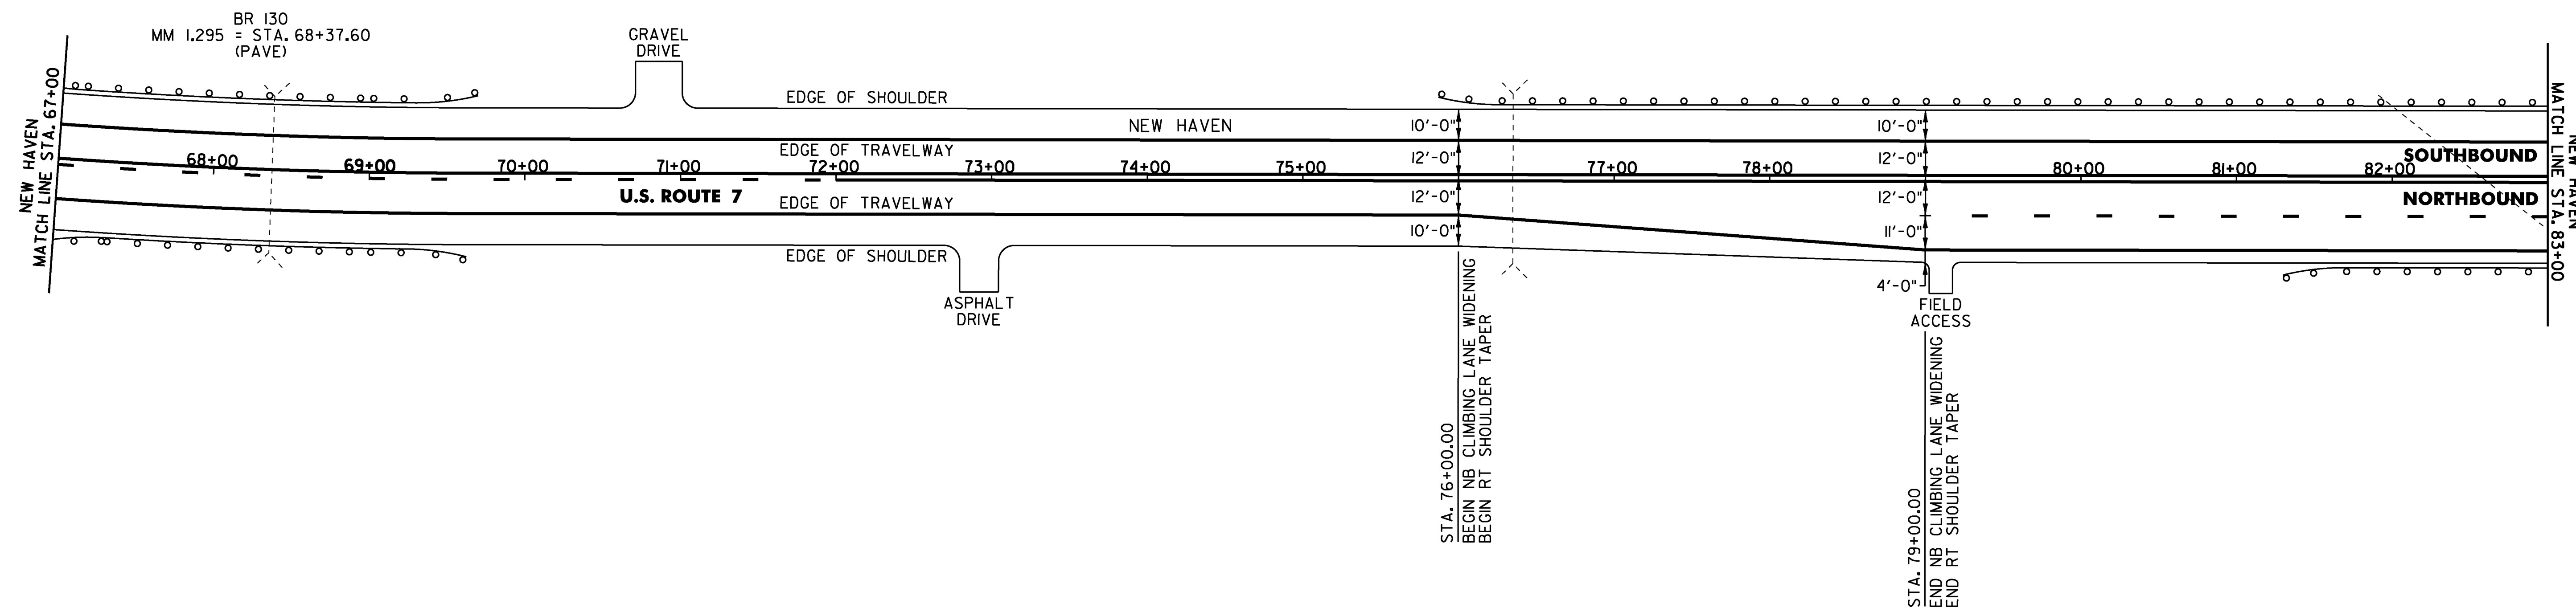

NOT TO SCALE

PROJECT NAME:	MIDDLEBURY-FERRISBURGH
PROJECT NUMBER:	NH SURF(55)
FILE NAME: p15v015.dgn	PLOT DATE: 16-MAR-2016
PROJECT LEADER: J. HARRINGTON	DRAWN BY: L. BULLOCK
DESIGNED BY: L. BULLOCK	CHECKED BY: J. HARRINGTON
PLAN SHEET 12	SHEET 26 OF 96