


TEMPORARY 4 INCH WHITE LINE, PAINT
 SPECIAL PROVISION (DURABLE 4 INCH WHITE LINE, POLYUREA)(28 MILS)
 (ALL LINES WILL INCLUDE EDGE LINE BREAKS AND
 RADIUS FOR TOWN HIGHWAYS)
 NEW HAVEN:
 STA. 131+00.0 - STA. 147+00.0 LT & RT

TEMPORARY 24 INCH STOP BAR, PAINT
 SPECIAL PROVISION (DURABLE 24 INCH STOP BAR, POLYUREA)(28 MILS) OR
 DURABLE 24 INCH STOP BAR, THERMOPLASTIC
 NEW HAVEN:
 STA. 131+78.88 LT, TH-5
 STA. 131+78.88 RT (State Police)

TEMPORARY LETTER OR SYMBOL, PAINT
 SPECIAL PROVISION (DURABLE LETTER OR SYMBOL, POLYUREA)(28 MILS) OR
 DURABLE LETTER OR SYMBOL, THERMOPLASTIC
 NEW HAVEN:
 STA. 131+78.88 LT, TH-5, "STOP" (4 EA)
 STA. 131+78.88 RT, "STOP" (4 EA)

TEMPORARY 4 INCH YELLOW LINE, PAINT
 SPECIAL PROVISION (DURABLE 4 INCH YELLOW LINE, POLYUREA)(28 MILS)
 (ALL LINES WILL INCLUDE C/L BREAKS FOR
 TOWN HIGHWAYS) S=SOLID, D=DASHED
 NEW HAVEN:
 STA. 131+78.88 DOUBLE SOLID LT, TH-5
 STA. 131+78.88 DOUBLE SOLID RT
 STA. 131+00.0 - STA. 132+50.0 S - S
 STA. 132+50.0 - STA. 138+50.0 S - D
 STA. 138+50.0 - STA. 142+50.0 - D - S
 STA. 142+50.0 - STA. 146+50.0 D - S
 STA. 146+50.0 - STA. 147+00.0 S - S

MILLED RUMBLE STRIPS (CENTERLINE)
 NEW HAVEN:
 STA. 131+00.00 - STA. 131+59.00 131+38
 132+25 STA. 131+99.00 - STA. 147+00.00 146+50

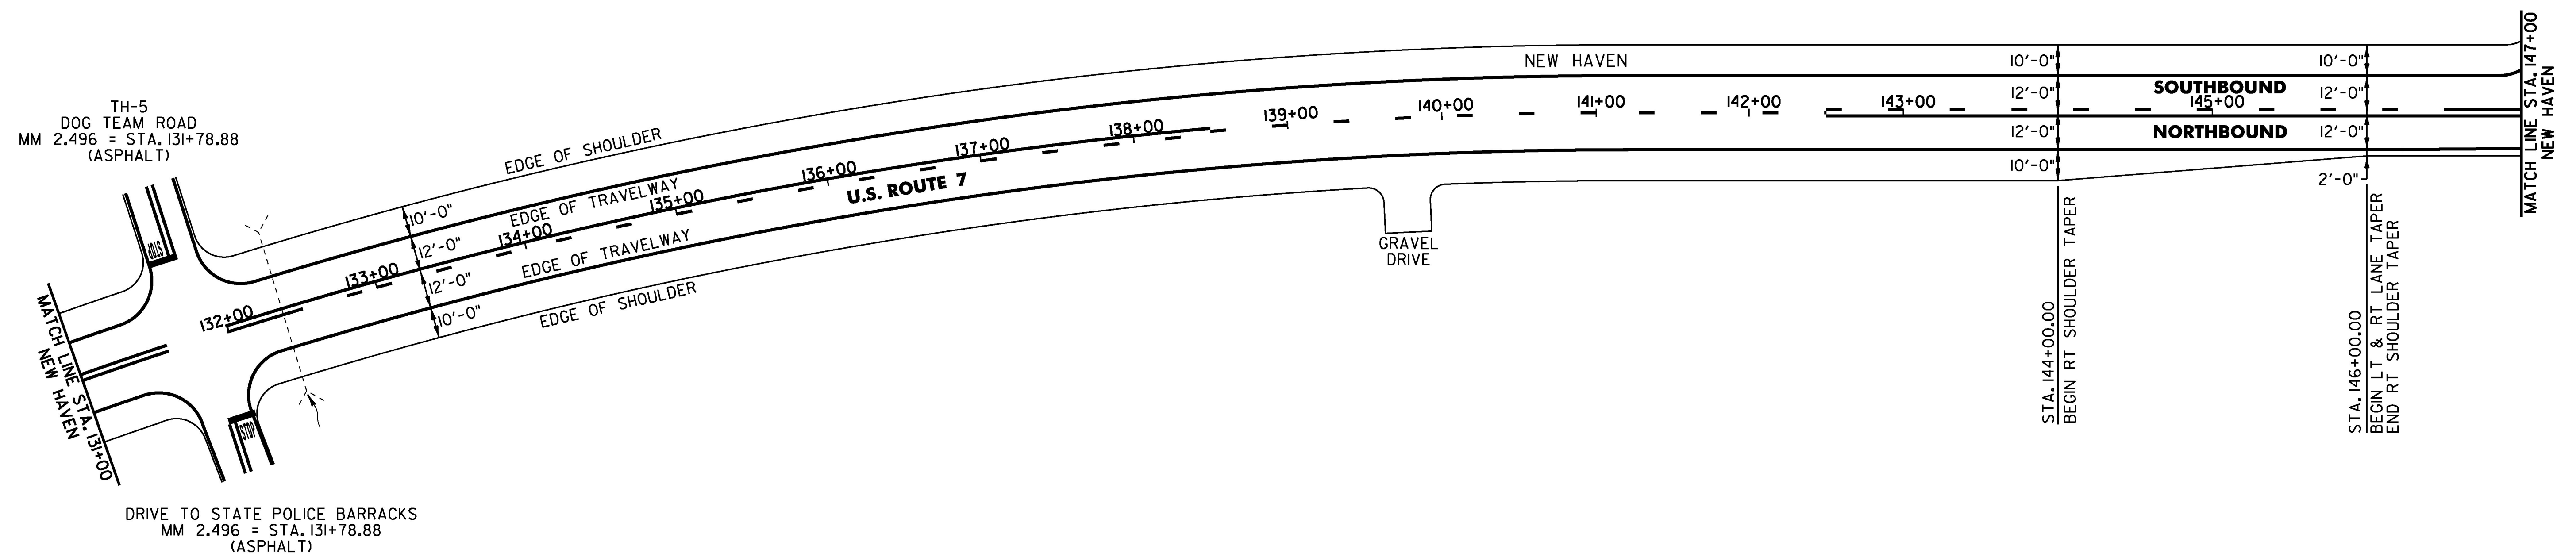

NOT TO SCALE

PROJECT NAME:	MIDDLEBURY-FERRISBURGH
PROJECT NUMBER:	NH SURF(55)
FILE NAME:	pl5v015.dgn
PROJECT LEADER:	J. HARRINGTON
DESIGNED BY:	L. BULLOCK
PLANNED BY:	L. BULLOCK
PLOT DATE:	16-MAR-2016
DRAWN BY:	L. BULLOCK
CHECKED BY:	J. HARRINGTON
PLAN SHEET 16	SHEET 30 OF 96