


TEMPORARY 4 INCH WHITE LINE, PAINT  
 SPECIAL PROVISION (DURABLE 4 INCH WHITE LINE, POLYUREA)(28 MILS)  
 (ALL LINES WILL INCLUDE EDGE LINE BREAKS AND  
 RADIUS FOR TOWN HIGHWAYS)  
 NEW HAVEN:  
 STA. 147+00.0 - STA. 163+00.0 LT & RT

TEMPORARY 24 INCH STOP BAR, PAINT  
 SPECIAL PROVISION (DURABLE 24 INCH STOP BAR, POLYUREA)(28 MILS) OR  
 DURABLE 24 INCH STOP BAR, THERMOPLASTIC  
 NEW HAVEN:  
 STA. 147+36.48 LT, TH 26  
 STA. 149+00.16 RT, TH-27

TEMPORARY LETTER OR SYMBOL, PAINT  
 SPECIAL PROVISION (DURABLE LETTER OR SYMBOL, POLYUREA)(28 MILS) OR  
 DURABLE LETTER OR SYMBOL, THERMOPLASTIC  
 NEW HAVEN:  
 STA. 147+36.48 LT, TH 26, "STOP" (4 EA)  
 STA. 149+00.16 RT, TH-27, "STOP" (4 EA)

TEMPORARY 4 INCH YELLOW LINE, PAINT  
 SPECIAL PROVISION (DURABLE 4 INCH YELLOW LINE, POLYUREA)(28 MILS)  
 (ALL LINES WILL INCLUDE C/L BREAKS FOR  
 TOWN HIGHWAYS) S=SOLID, D=DASHED  
 NEW HAVEN:  
 STA. 147+36.48 DOUBLE SOLID LT, TH-26 LT ☉ RT  
 STA. 147+00.0 - STA. 153+50.0 S - S  
 STA. 153+50.0 - STA. 160+50.0 D - S  
 STA. 160+50.0 - STA. 162+50.0 - D -  
 STA. 162+50.0 - STA. 163+00.0 S - D  
 STA. 149+00.16 DOUBLE SOLID RT, TH-27

MILLED RUMBLE STRIPS (CENTERLINE)  
 NEW HAVEN:  
 STA. 147+00.00 - STA. 147+16.00  
 STA. 147+56.00 - STA. 148+80.00  
 149+09 STA. 149+20.00 - STA. 156+29.00 156+50  
 STA. 158+40.00 - STA. 163+00.00  
 STA 158+62 - STA 161+34

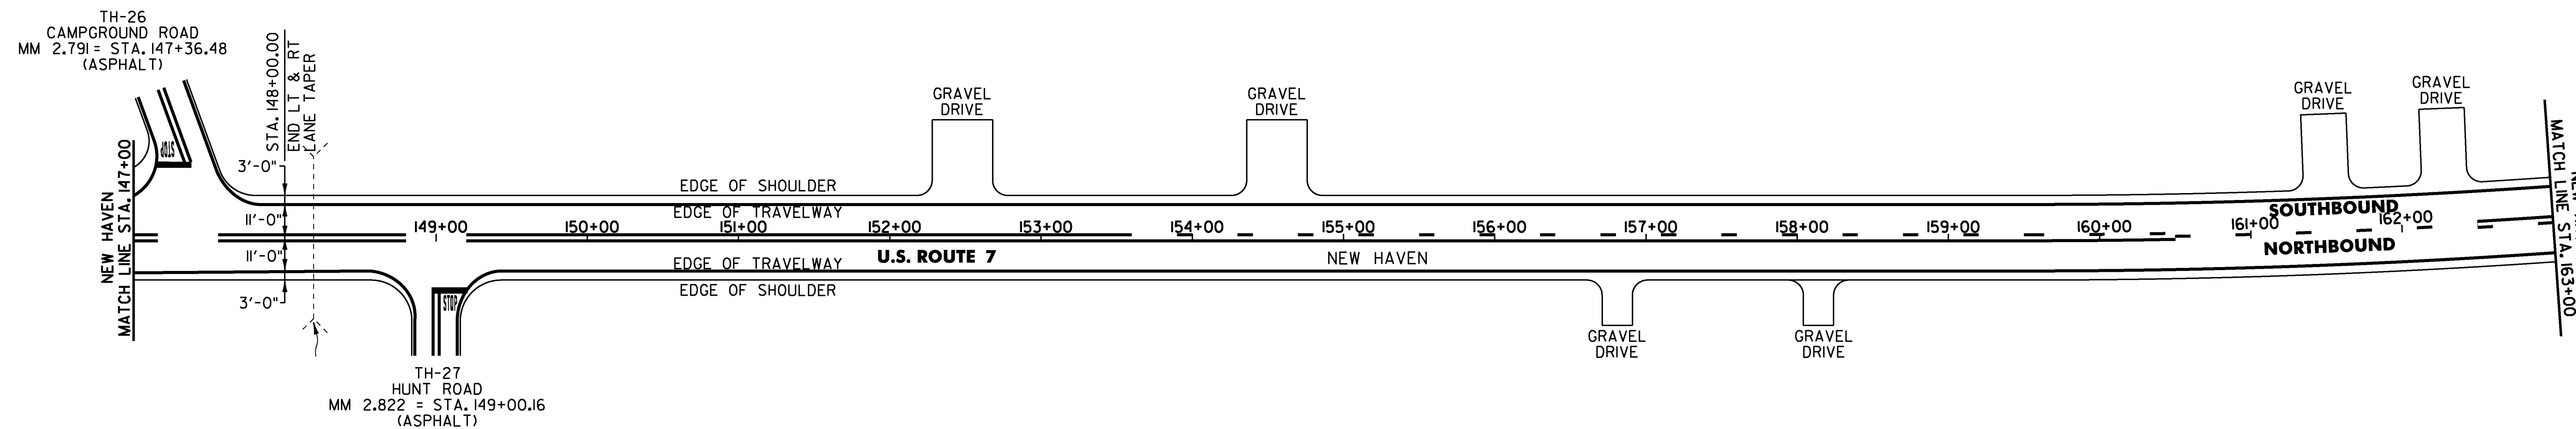

NOT TO SCALE

PROJECT NAME: MIDDLEBURY-FERRISBURGH	
PROJECT NUMBER: NH SURF(55)	
FILE NAME: p15v015.dgn	PLOT DATE: 16-MAR-2016
PROJECT LEADER: J. HARRINGTON	DRAWN BY: L. BULLOCK
DESIGNED BY: L. BULLOCK	CHECKED BY: J. HARRINGTON
PLAN SHEET 17	SHEET 31 OF 96