

TEMPORARY 4 INCH WHITE LINE, PAINT
 SPECIAL PROVISION (DURABLE 4 INCH WHITE LINE, POLYUREA)(28 MILS)
 (ALL LINES WILL INCLUDE EDGE LINE BREAKS AND RADIUS FOR TOWN HIGHWAYS)
 NEW HAVEN:
 STA. 195+00.0 - STA. 211+00.0 LT & RT
 STA. 195+00.0 - STA. 198+00.0 DASHED LT

TEMPORARY 4 INCH YELLOW LINE, PAINT
 SPECIAL PROVISION (DURABLE 4 INCH YELLOW LINE, POLYUREA)(28 MILS)
 (ALL LINES WILL INCLUDE C/L BREAKS FOR TOWN HIGHWAYS) S=SOLID, D=DASHED
 NEW HAVEN:
 STA. 195+00.0 - STA. 206+50.0 S - S
 STA. 206+50.0 - STA. 211+00.0 S - D


TEMPORARY 24 INCH STOP BAR, PAINT
 SPECIAL PROVISION (DURABLE 24 INCH STOP BAR, POLYUREA)(28 MILS) OR DURABLE 24 INCH STOP BAR, THERMOPLASTIC
 NEW HAVEN:
 STA. 205+65.60 RT, TH-3

TEMPORARY 8 INCH WHITE LINE, PAINT
 SPECIAL PROVISION (DURABLE 8 INCH WHITE LINE, POLYUREA)(28 MILS)
 NEW HAVEN:
 STA. 204+45.0 - STA. 204+80.0 GORE AREA RT
 STA. 205+65.60 GORE AREA RT, TH-3

MILLED RUMBLE STRIPS (CENTERLINE)
 NEW HAVEN:
 STA. 195+00.00 - STA. 200+64.00 203+00
 210+62 STA. 208+56.00 - STA. 211+00.00

SPECIAL PROVISION (DURABLE LETTER OR SYMBOL, POLYUREA)(28 MILS) OR DURABLE LETTER OR SYMBOL, THERMOPLASTIC
 NEW HAVEN:
 STA. 205+11.0 RT, TH-3, YIELD LINE (5 EA)
 STA. 205+65.60 RT, TH-3, "STOP" (4 EA)
 STA. 195+09 LT ARROW

TEMPORARY LETTER OR SYMBOL, PAINT
 NEW HAVEN:
 STA. 195+09.00 LT, ARROW
 STA. 205+65.60 RT, TH-3, "STOP" (4 EA)

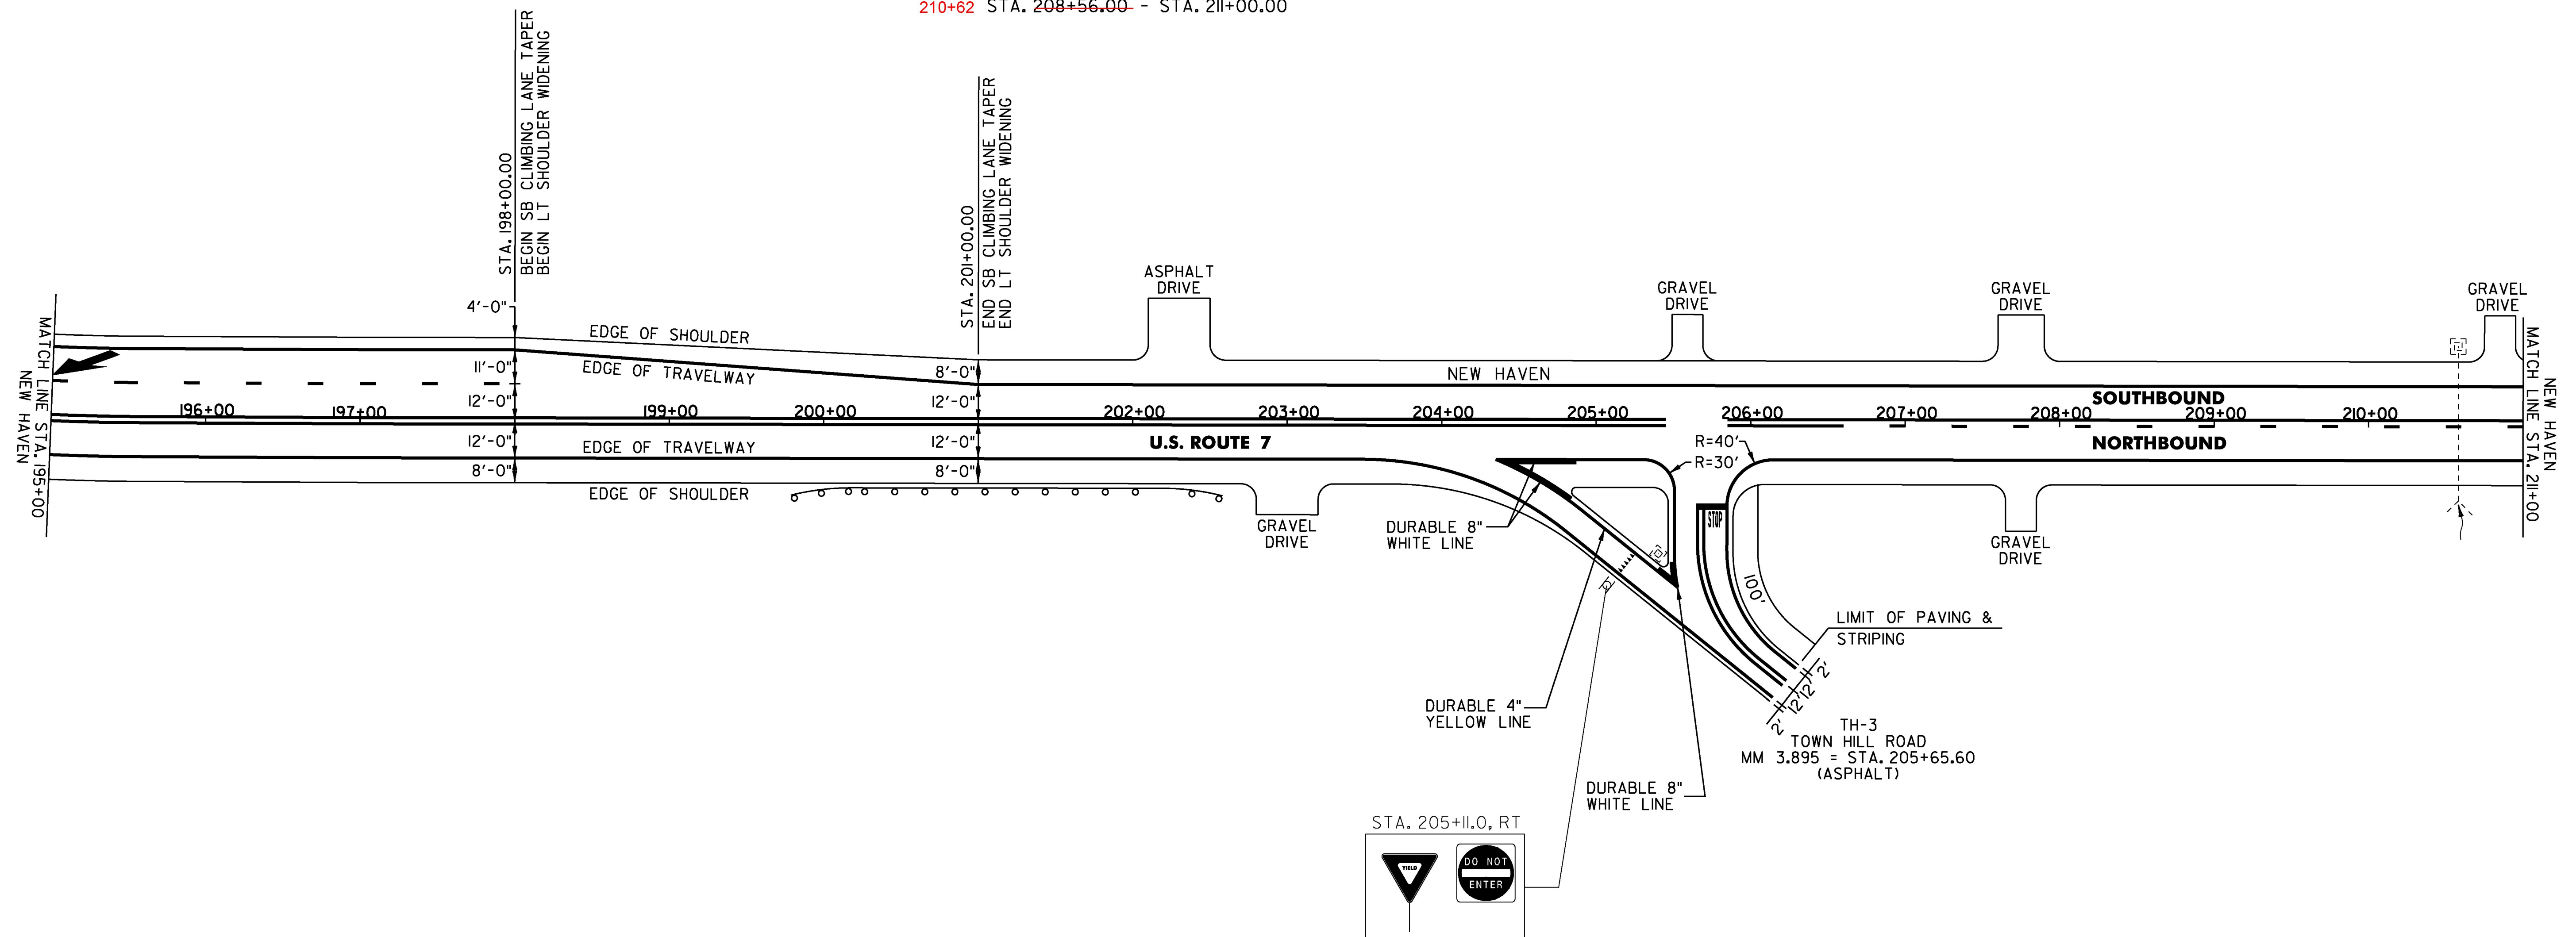

NOT TO SCALE

PROJECT NAME:	MIDDLEBURY-FERRISBURGH
PROJECT NUMBER:	NH SURF(55)
FILE NAME:	pl5v015.dgn
PROJECT LEADER:	J. HARRINGTON
DESIGNED BY:	L. BULLOCK
PLAN SHEET 20	
PLOT DATE:	16-MAR-2016
DRAWN BY:	L. BULLOCK
CHECKED BY:	J. HARRINGTON
SHEET 34	OF 96