


TEMPORARY 4 INCH WHITE LINE, PAINT
 SPECIAL PROVISION (DURABLE 4 INCH WHITE LINE, POLYUREA)(28 MILS)
 (ALL LINES WILL INCLUDE EDGE LINE BREAKS AND
 RADIUS FOR TOWN HIGHWAYS)
 NEW HAVEN:
 STA. 211+00.0 - STA. 227+00.0 LT & RT

MILLED RUMBLE STRIPS (CENTERLINE)
 NEW HAVEN:
 STA. 211+00.00 - STA. 218+59.00 218+55
 223+73 STA. 223+34.00 - STA. 227+00.00

TEMPORARY 4 INCH YELLOW LINE, PAINT
 SPECIAL PROVISION (DURABLE 4 INCH YELLOW LINE, POLYUREA)(28 MILS)
 (ALL LINES WILL INCLUDE C/L BREAKS FOR
 TOWN HIGHWAYS) S=SOLID, D=DASHED
 NEW HAVEN:
 STA. 211+00.0 - STA. 212+00.0 LT C RT
 STA. 212+00.0 - STA. 227+00.0 S D -

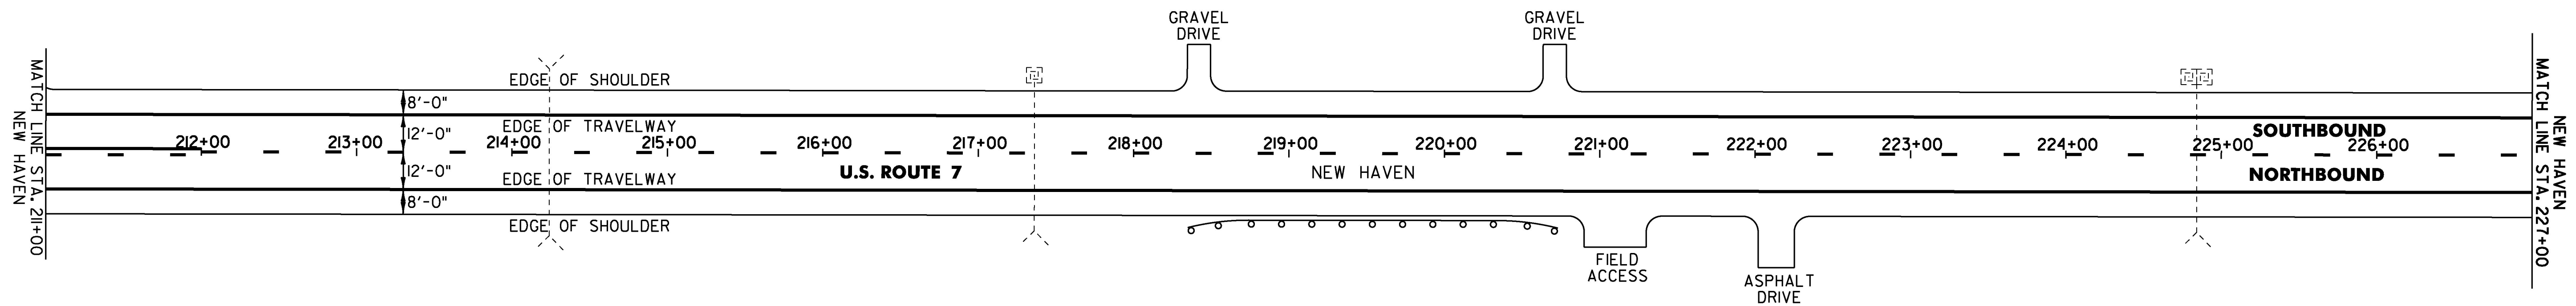

NOT TO SCALE

PROJECT NAME:	MIDDLEBURY-FERRISBURGH
PROJECT NUMBER:	NH SURF(55)
FILE NAME:	pl5v015.dgn
PROJECT LEADER:	J. HARRINGTON
DESIGNED BY:	L. BULLOCK
PLAN SHEET 21	
PLOT DATE:	16-MAR-2016
DRAWN BY:	L. BULLOCK
CHECKED BY:	J. HARRINGTON
SHEET	35 OF 96